

Registration Statement

OF CLAIMANT OF RIGHT TO APPROPRIATE GROUND WATER

TO THE STATE ENGINEER OF OREGON:

I, CITY WATER DEPARTMENT

of SALEM County of CLATSOP

(Mailing address)

State of OREGON, do hereby make application for a certificate of registration as evidence of a right to appropriate ground water.

1. Source from which water is withdrawn is PIPED WELL

(Flowing well, pump well, infiltration trench, or tunnel)

2. Location is: STAYTON ISLAND, APPROX. 2MI. E. OF STAYTON

(Approximate distance and direction from nearest city or town)

and is more particularly described as follows: WELL #11

(a) 860' S. & 660' E. OF NW COR. SEC. 13

(Give distance and bearing to corner of section or other legal subdivision)

being within NW 1/4 NW 1/4 of Sec. 13, Twp. 09, Rge. 1W

(Smallest legal subdivision)

(N. or S.)

(E. or W.)

or (b) within limits of recorded platted property, town or city:

in Lot _____ Block _____ of _____

(Name of plat or addition)

County of LINN

(If within city or town, give name)

3. Construction Work was begun on JUNE 20, 1940; was completed on 1940

(Date)

(Date)

and the ground water claimed was first used for the purposes set out below on 1940

(Date)

since which time the water has been used INTERMITTENTLY

(Continuously or intermittently)

from 1940 to PRESENT

(Date)

(Date)

4. Quantity of water claimed and used is 1100 gallons per minute; _____ acre feet per year.

5. Purpose or Purposes for which water is used MUNICIPAL WATER SUPPLY

(Domestic, irrigation, municipal, manufacturing, industrial, etc.)

6. Description of Well: Depth 60' feet. Type DRILLED

(Dug or drilled)

diameter 12" I.D. inches. Elevation of ground at well site 100 feet, mean sea level.

(As near as known)

Depth to water table 12 feet.

7. Capacity of Well: 110 g.p.m. with Unknown feet drawdown.

_____ g.p.m. with _____ feet drawdown.

Date of test 12-24-40

If Flowing Well: Measured discharge _____ g.p.m. on _____

(Date)

Shut-in pressure at ground surface _____ lbs. per sq. in. on _____

(Date)

Water is controlled by _____

(Cap, valve, etc.)

8. Casing: (Give diameter, commercial specifications and depth below ground surface of each casing size.)

inch diameter NO CASING DATA AVAILABLE from to feet
 inch diameter from to feet
 inch diameter from to feet
 inch diameter from to feet

Describe and show depth of shoe, plug, adapter, liner or other details: LOG SHEET; 1 STRAINER PLUG
 10 FT. 8" SECTION

9. Perforated Casings or Screens:

8" STRAINER WELDED TO SECTION from to
(Number per foot and size of perforations, or describe screen)
 (No Further Data Available) from to
 from to
 from to

10. Log of Well: (Describe each stratum or formation clearly, indicate if water bearing, and give thickness and depth as indicated.)

MATERIAL	Thickness (Feet)	Depth to Bottom (Feet)
No Data Available		

If log of well is not available, give name and address of driller.

11. Infiltration Trench: Covered or open

Dimensions: Length ft. Minimum depth ft. Maximum depth ft.

Bottom width ft. Discharge g.p.m. Date of test

12. Tunnel: Type of lining

Dimensions:
(Length, course, and cross sectional size)

Position of water bearing stratum with reference to portal of tunnel

Log of tunnel: (Preceding table for log of well may be used, if desired. Give footage from portal and character of materials, as pertinent.)

13. Pumping Equipment:

(a) Pump STERLING VERTICAL TURBINE 10W Capacity 1100 g.p.m.
(Make, type and size)

(b) Motor U.S. MOTOR, 3CV, 10H.P.
(Type and horsepower)

14. Location of area irrigated or to be irrigated, or place of use if for purposes other than irrigation.


Township North or South	Range E. or W. of Willamette Meridian	Section	Forty-acre Tract	Number Acres To Be Irrigated	Date of Reclamation
AREA USED FOR STORAGE FOR CITY OF SALEM WATER SUPPLY					
City of Salem and adjacent service areas					
T75	R3W	22	E 1/2	Municipal	1936
"	"	23	W 1/2	"	"
"	"	24	all	"	"
"	"	27	all	"	"
"	"	28	all	"	"
"	"	34	N 1/2	"	"
"	"	35	N 1/2	"	"

15. If the ground water supply is supplemental to an existing water supply, identification of any application for a permit, permit, certificate or adjudicated right to appropriate water made or held by the registrant.

Cert. No 12323, Application No 25569, State Engineer Special Order Records Vol 7, p 236

Permit No. 3731, and eight registration statements accompanying this one.

Township 9S Range 1W W.M.
North

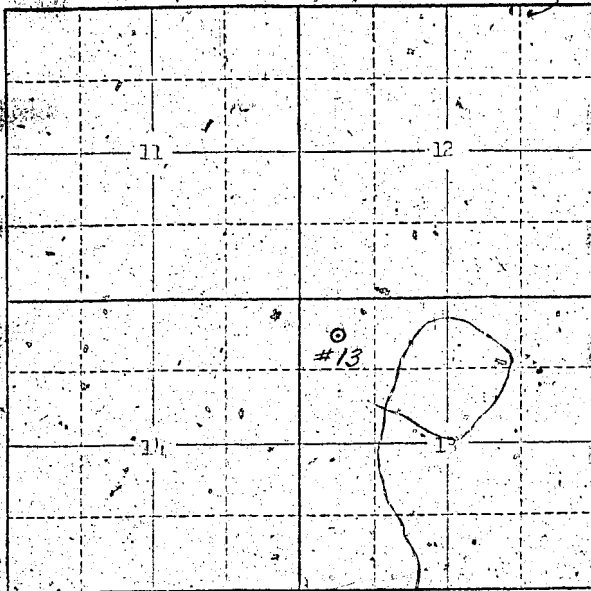

Locate well and acreage of irrigated land on plat.
Scale: 2" = 1 Mile

STATE OF OREGON

County of MARION

ss.

I, JOHN L. GEREN, being first duly sworn, do hereby certify that I have read the foregoing Registration Statement and that all of the items therein contained are true to the best of my knowledge and belief.

John L. Geren
(Signature of Registrant)

Subscribed and sworn to before me this 20th day of July, 1939

My commission expires Jan 31 1941

(Notary Public)

(SEAL)

CERTIFICATE OF REGISTRATION

STATE OF OREGON

County of Marion

ss.

This is to certify that the foregoing Registration Statement was received in the office of the State Engineer on the 20th day of July, 1939, at 11 o'clock A.M. and has been duly recorded in said office in Book No. 13 of Registration Statements on page GR 3229

Witness my hand this 20th day of July, 1939

(State Engineer)

By (Deputy)

\$24.00

GR 3229