

Registration Statement

OF CLAIMANT OF RIGHT TO APPROPRIATE GROUND WATER

TO THE STATE ENGINEER OF OREGON:

The United States of America, represented by the Corps of Engineers,
U.S. Army Engineer District, Portland

of 628 Pittock Block, Portland 5, Oregon County of Multnomah
(Mailing address)

State of Oregon does hereby make application for a certificate of registration as evidence of a right to appropriate ground water.

1. Source from which water is withdrawn is pump well
(Flowing well, pump well, infiltration trench, or tunnel)

2. Location is: Leaburg Fish Hatchery, 1/2 mile east of Leaburg, Oregon,
(Approximate distance and direction from nearest city or town)

and is more particularly described as follows:

(a) 887 feet S. 51° E. to East quarter corner of Section 31
(Give distance and bearing to corner of section or other legal subdivision)

being within SE 1/4 of the NE 1/4 of Sec. 31, Twp. 16 S., Rge. 2 E., W.M.
(Smallest legal subdivision) (N. or S.) (E. or W.)

or (b) within limits of recorded platted property, town or city:

in Lot _____, Block _____ of _____
(Name of plat or subdivision)

County of Lane
(If within city or town, give name)

3. Construction Work was begun in 1952; was completed in January 1953
(Date) (Date)

and the ground water claimed was first used for the purposes set out below in 1953 or 1954
(Date)

since which time the water has been used continuously
(Continuously or intermittently)

from _____ to _____
(Date) (Date)

4. Quantity of water claimed and used is 55 gallons per minute; _____ acre feet per year.

5. Purpose or Purposes for which water is used General project purposes, supplying all installations and fire protection. (Industrial)
(Domestic, irrigation, municipal, manufacturing, industrial, etc.)

6. Description of Well: Depth 75 feet. Type drilled
(Dug or drilled)
diameter 8 inches. Elevation of ground at well site +753.0 feet, mean sea level
(As near as known)
Depth to water table 33 feet.

7. Capacity of Well: 70 g.p.m. with 12 feet drawdown.

95 g.p.m. with 34 feet drawdown.


Date of test January 5, 1953 (Tested by Ramsay-Waite Company)

If Flowing Well: Measured discharge _____ g.p.m. on _____
(Date)

Shut-in pressure at ground surface _____ lbs. per sq. in. on _____
(Date)

Water is controlled by _____
(Cap, valve, etc.)

Township 16S Range 2E, W.M.
North

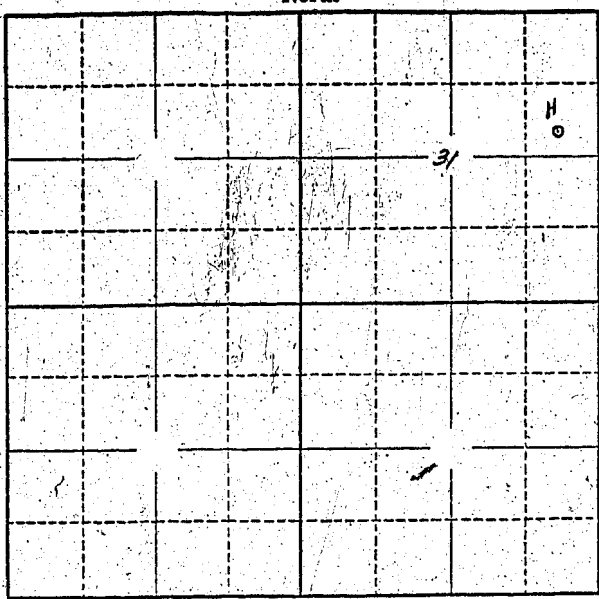

Locate well and acreage of irrigated land on plat.
Scale: 2" = 1 Mile

STATE OF OREGON }
County of Multnomah } ss.

I, Merle E. Lietzke, being first duly sworn, do hereby certify that I have read the foregoing Registration Statement and that all of the items therein contained are true to the best of my knowledge and belief.

Merle E. Lietzke
MERLE E. LIETZKE, Chief, Real Estate Division
(Signature of Registrant)
U.S. Army Engineer District, Portland.

Subscribed and sworn to before me this 29 day of July, 1958

My commission expires March 15, 1959

[Signature]
(Notary Public)
Notary Public for State of Oregon

(SEAL)

CERTIFICATE OF REGISTRATION

STATE OF OREGON }
County of Marion } ss.

This is to certify that the foregoing Registration Statement was received in the office of the State Engineer on the 31st day of July, 1958, at 2:00 o'clock P.M. and has been duly recorded in said office in Book No. 6 of Registration Statements on page GR-1230

Witness my hand this 19 day of September, 1958
Laura A. Stanley
(State Engineer)

By _____
(Deputy)