

# Registration Statement

## OF CLAIMANT OF RIGHT TO APPROPRIATE GROUND WATER

TO THE STATE ENGINEER OF OREGON:

I, BATE LUMBER COMPANY  
of MERLIN County of JOSEPHINE  
(Mailing address)

State of OREGON, do hereby make application for a certificate of registration as evidence of a right to appropriate ground water.

1. Source from which water is withdrawn is Pumpwell  
(Flowing well, pump well, infiltration trench, or tunnel)

2. Location is: 1/2 mile east of Merlin, Oregon  
(Approximate distance and direction from nearest city or town)

and is more particularly described as follows:

(a) 320' E 47° 30' N center Section 21, T. 35S., R. 6W.  
(Give distance and bearing to corner of section or other legal subdivision)

being within S1/2 S1/4 NE1/4 of Sec. 21, Twp. 35S., Rge. 6W. LM.  
(Smallest legal subdivision) (N. or S.) (E. or W.)

or (b) within limits of recorded platted property, town or city:

in Lot \_\_\_\_\_ Block \_\_\_\_\_ of \_\_\_\_\_  
(Name of plat or addition)

County of \_\_\_\_\_  
(If within city or town, give name)

3. Construction Work was begun on August 1951 Unknown; was completed on Prior 1956  
(Date) (Date)

and the ground water claimed was first used for the purposes set out below on Prior 1956  
(Date)

since which time the water has been used Continuously  
(Continuously or Intermittently)

from Prior 1956 to Present date  
(Date) (Date)

4. Quantity of water claimed and used is 40 gallons per minute; \_\_\_\_\_ acre feet per year.

5. Purpose or Purposes for which water is used Industrial  
(Domestic, irrigation, municipal, manufacturing, industrial, etc.)

6. Description of Well: Depth 214 feet. Type drilled  
(Dug or drilled)

diameter 12 inches. Elevation of ground at well site 900 feet, mean sea level.  
(As near as known)

Depth to water table unknown feet.

7. Capacity of Well: unknown g.p.m. with \_\_\_\_\_ feet drawdown.

\_\_\_\_\_ g.p.m. with \_\_\_\_\_ feet drawdown.

Date of test \_\_\_\_\_

If Flowing Well: Measured discharge \_\_\_\_\_ g.p.m. on \_\_\_\_\_  
(Date)

Shut-in pressure at ground surface \_\_\_\_\_ lbs. per sq. in. on \_\_\_\_\_  
(Date)

Water is controlled by \_\_\_\_\_  
(Cap, valve, etc.)

8. Casing: (Give diameter, commercial specifications and depth below ground surface of each casing size.)

12 inch diameter ..... from surface to 214 feet  
..... inch diameter ..... from ..... to ..... feet  
..... inch diameter ..... from ..... to ..... feet  
..... inch diameter ..... from ..... to ..... feet

Describe and show depth of shoe, plug, adapter, liner or other details:  
.....  
..... Unknown

9. Perforated Casings or Screens:

..... Unknown ..... from ..... to .....  
(Number per foot and size of perforations, or describe screen)  
..... from ..... to .....  
..... from ..... to .....  
..... from ..... to .....

10. Log of Well: (Describe each stratum or formation clearly, indicate if water bearing, and give thickness and depth as indicated.)

MATERIAL	Thickness (Feet)	Depth to Bottom (Feet)
Unknown		

If log of well is not available, give name and address of driller.

Unknown

11. Infiltration Trench: Covered or open, None.

Dimensions: Length ..... ft. Minimum depth ..... ft. Maximum depth ..... ft.

Bottom width ..... ft. Discharge ..... g.p.m. Date of test .....

12. Tunnel: Type of lining, None

Dimensions: ..... (Length, course, and cross sectional size)

Position of water bearing stratum with reference to portal of tunnel .....

Log of tunnel: (Preceding table for log of well may be used, if desired. Give footage from portal and character of materials, as pertinent.)

13. Pumping Equipment:

(a) Pump ..... Cook Centrifical ..... Capacity ..... g.p.m.  
(Make, type and size)


(b) Motor ..... Motor General Electric 15 HP .....  
(Type and horsepower)

14. Location of area irrigated or to be irrigated, or place of use if for purposes other than irrigation.

Township North or South	Range E. or W. of Willamette Meridian	Section	Forty-acre Tract	Number Acres To Be Irrigated	Date of Reclamation
T 35 S	R 6 W	21	SW 1/4 NE 1/4 FR SE 1/4 NW 1/4	Bate Lumber Co. Mill Site	

15. If the ground water supply is supplemental to an existing water supply, identification of any application for a permit, permit, certificate or adjudicated right to appropriate water made or held by the registrant.

Township 35S Range 6W W.M.  
North

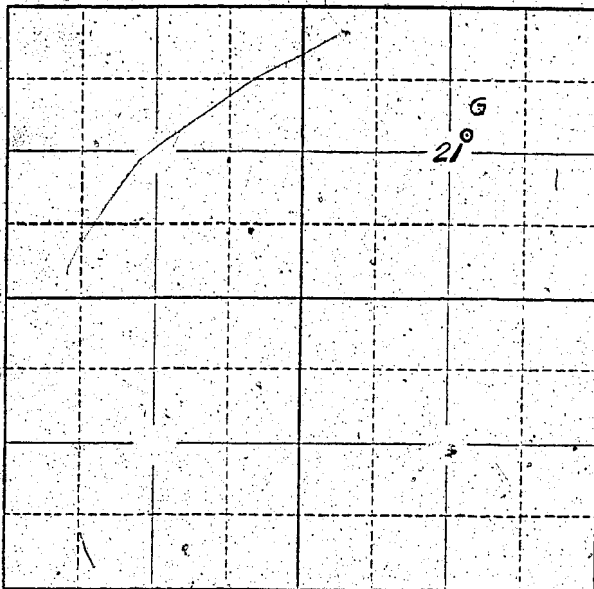

Locate well and acreage of irrigated land on plat.

Scale: 2" = 1 Mile  
2

STATE OF OREGON

County of JOSEPHINE } ss.

I, C. L. LINDQUIST, being first duly sworn, do hereby certify that I have read the foregoing Registration Statement and that all of the items therein contained are true to the best of my knowledge and belief.

STATE LUMBER COMPANY

By: [Signature]  
(Signature of Registrant) ASST Sec'y & Mgr.

Subscribed and sworn to before me this 31 day of July, 1958.

My commission expires \_\_\_\_\_

(Notary Public)

(SEAL)

### CERTIFICATE OF REGISTRATION

STATE OF OREGON

County of Marion } ss.

This is to certify that the foregoing Registration Statement was received in the office of the State Engineer on the 31 day of July, 1958, at 8:10 o'clock A. M. and has been duly recorded in said office in Book No. 14 of Registration Statements on page GR-3236

Witness my hand this 20<sup>th</sup> day of July, 1959.

(State Engineer)

By \_\_\_\_\_

(Deputy)

GR - 3236

\$ 20.00