

Registration Statement

OF CLAIMANT OF RIGHT TO APPROPRIATE GROUND WATER

TO THE STATE ENGINEER OF OREGON:

I, Beland J. Seegerof 5120 Seeger Lane, Salem, County of Marion
(Mailing address)State of Oregon, do hereby make application for a certificate of registration as evidence of a right to appropriate ground water:

1. Source from which water is withdrawn is Pump Well #1
(Flowing well, pump well, infiltration trench, or tunnel)
2. Location is: 5 Miles South of Salem, Oregon
(Approximate distance and direction from nearest city or town)

and is more particularly described as follows:

(a) 750' South & 125653' West from NE Corner Sec 16
(Give distance and bearing to corner of section or other legal subdivision)
being within SE 1/4 of NE 1/4 of Sec. 16, Twp. 8S, Rge. 3W
(Smallest legal subdivision) (N. or S.) (E. or W.)

or (b) within limits of recorded platted property, town or city:

in Lot _____, Block _____ of _____
(Name of plat or addition)

(If within city or town, give name) County of _____

3. Construction Work was begun on July 19, 1941; was completed on August 1, 1941
(Date) (Date)

and the ground water claimed was first used for the purposes set out below on July 20, 1950
(Date)since which time the water has been used Continuously
(Continuously or intermittently)from July 20, 1950 to July 23, 1958
(Date) (Date)

4. Quantity of water claimed and used is 8.6 gallons per minute; _____ acre feet per year.

5. Purpose or Purposes for which water is used Domestic & Irrigation
(Domestic, irrigation, municipal, manufacturing, industrial, etc.)

6. Description of Well: Depth 56' feet. Type Drilled
(Dug or drilled)
diameter 5" inches. Elevation of ground at well site 320' feet, mean sea level.
(As near as known)
Depth to water table 50' feet.

7. Capacity of Well: Not Known g.p.m. with _____ feet drawdown.
Not Known g.p.m. with _____ feet drawdown.

Date of test _____

If Flowing Well: Measured discharge are not a flow well g.p.m. on _____
(Date)Shut-in pressure at ground surface _____ lbs. per sq. in. on _____
(Date)Water is controlled by _____
(Cap, valve, etc.)

Well #1

Welt 25

1

100

10

Describe

9.

—

.....

.....

10

10.
ness and

ness and

Wall #2

If log of well is not available, give name and address of driller.

11. Infiltration Trench: Covered or open

Dimensions: Length ft. Minimum depth ft. Maximum depth ft.

Bottom width ft. Discharge g.p.m. Date of test

12. Tunnel: Type of lining

Dimensions: _____
(Length, course, and cross sectional size)

Position of water bearing stratum with reference to portal of tunnel

Log of tunnel: (Preceding table for log of well may be used, if desired. Give footage from portal and character of materials, as pertinent.)

13.4 Pumping Equipment:

(a) Pump Jet-Universal Capacity 23 g.p.m.
(Make, type and size)


(b) Motor 140 ELECTRIC (Type and horsepower)

14. Location of area irrigated or to be irrigated, or place of use if for purposes other than irrigation.

[illegible]

15. If the ground water supply is supplemental to an existing water supply, identification of any application for a permit, permit, certificate or adjudicated right to appropriate water made or held by the registrant.

Township 85 Range 3W W.M.
North

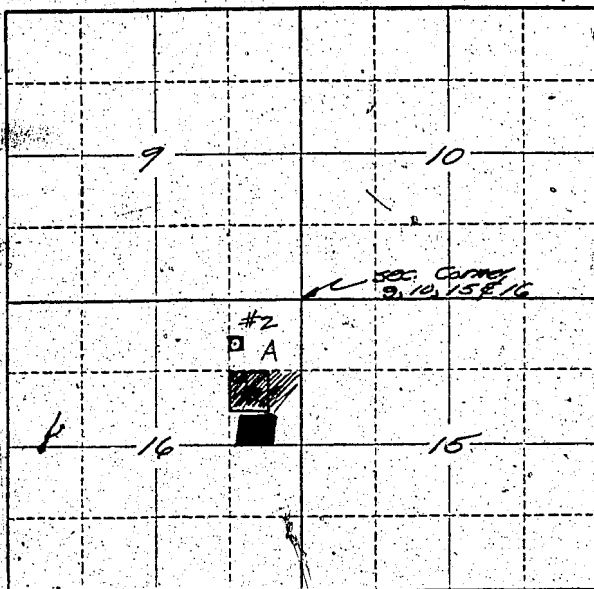

Locate well and acreage of irrigated land on plat.

Scale: 2" = 1 Mile

STATE OF OREGON

County of Marion

ss.

I, Richard D. Stanley, being first duly sworn, do hereby certify that I have read the foregoing Registration Statement and that all of the items therein contained are true to the best of my knowledge and belief.

(Signature of Registrant)

Subscribed and sworn to before me this 31st day of July, 1958.

My commission expires June 15 1960

(Notary Public)

(SEAL)

CERTIFICATE OF REGISTRATION

STATE OF OREGON

County of Marion

ss.

This is to certify that the foregoing Registration Statement was received in the office of the State Engineer on the 31 day of July, 1958, at 3:50 o'clock P. M. and has been duly recorded in said office in Book No. 14 of Registration Statements on page GR 3240

Witness my hand this 20th day of July, 1959

(State Engineer)

By

(Deputy)

GR - 3240