

Registration Statement

OF CLAIMANT OF RIGHT TO APPROPRIATE GROUND WATER

TO THE STATE ENGINEER OF OREGON:

I, JESSE P. OWRE

of Rt. 1 Box 400 Hubbard
(Mailing address)

County of MARIAN

State of OREGON, do hereby make application for a certificate of registration as evidence of a right to appropriate ground water.

1. Source from which water is withdrawn is PUMP WELL
(Flowing well, pump well, infiltration trench, or tunnel)

2. Location is: 2 mi. west of Hubbard
(Approximate distance and direction from nearest city or town)

and is more particularly described as follows:

(a) 825' S and 1350' E of NW corner of Joseph Churchill D.L.C.
(Give distance and bearing to corner of section or other legal subdivision)

being within SW 1/4 NE 1/4 of Sec. 31, Twp. 4 S Rge. 1 W
(Smallest legal subdivision) (N. or S.) (E. or W.)

or (b) within limits of recorded platted property, town or city:

in Lot _____, Block _____ of D.L.C. No. 56 (Joseph Churchill D.L.C.)
(Name of plat or addition)

County of Marian
(If within city or town, give name)

3. Construction Work was begun on April 15/51; was completed on May 15/51
(Date) (Date)

and the ground water claimed was first used for the purposes set out below on May 15/51
(Date)

since which time the water has been used Intermittently
(Continuously or Intermittently)

from May 15/51 to Present July 1958
(Date) (Date)

4. Quantity of water claimed and used is 350 gallons per minute; 1.5 acre feet per year.

5. Purpose or Purposes for which water is used IRRIGATION

(Domestic, irrigation, municipal, manufacturing, industrial, etc.)

6. Description of Well: Depth 140 feet. Type Drilled
(Dug or drilled)

diameter 8 inches. Elevation of ground at well site 175 feet, mean sea level.
(As near as known)

Depth to water table 17 feet.

7. Capacity of Well: 350 g.p.m. with 6.5 feet drawdown.
650 g.p.m. with 9.3 feet drawdown.


Date of test March 15/55

If Flowing Well: Measured discharge _____ g.p.m. on _____
(Date)

Shut-in pressure at ground surface _____ lbs. per sq. in. on _____
(Date)

Water is controlled by _____
(Cap, valve, etc.)

Township 4S Range 1W W.M.
North

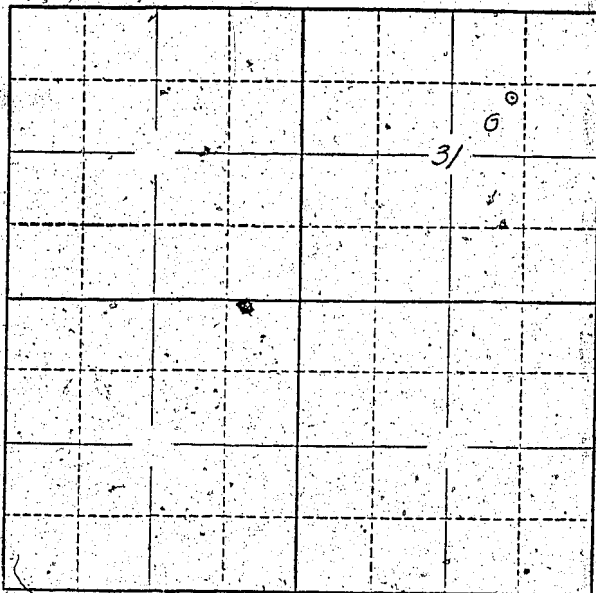

Locate well and acreage of irrigated land on plat.

Scale: 2" = 1 Mile

STATE OF OREGON

County of Marion } ss.

I, Jesse C. Oure, being first duly sworn, do hereby certify that I have read the foregoing Registration Statement and that all of the items therein contained are true to the best of my knowledge and belief.

Jesse C. Oure
(Signature of Registrant)

Subscribed and sworn to before me this 31st day of July, 1958

My commission expires 12th June 1961

W. S. Bartholomew
(Notary Public)

(SEAL)

CERTIFICATE OF REGISTRATION

STATE OF OREGON

County of Marion } ss.

This is to certify that the foregoing Registration Statement was received in the office of the State Engineer on the 31st day of July, 1958, at 1⁰⁰ o'clock P. M. and has been duly recorded in said office in Book No. 14 of Registration Statements on page GR 3241

Witness my hand this 20th day of July, 1959

Lewis A. Stanley
(State Engineer)

By _____ (Deputy)

GR 3241

20.40