

# Registration Statement

## OF CLAIMANT OF RIGHT TO APPROPRIATE GROUND WATER

TO THE STATE ENGINEER OF OREGON:

I, Carl Branienfels

of St. Helens County of Columbia

State of Oregon, do hereby make application for a certificate of registration as evidence of a right to appropriate ground water.

1. Source from which water is withdrawn is pump well #2  
(Flowing well, pump well, infiltration trench, or tunnel)

2. Location is: 4 miles west of St. Helens, Oregon  
(Approximate distance and direction from nearest city or town)

and is more particularly described as follows:

(a) 1500 feet NW of SE corner of Sec 35, R5N, 2W  
(Give distance and bearing to corner of section or other legal subdivision)

being within SE $\frac{1}{4}$  of SE $\frac{1}{4}$  of Sec. 35, Twp. 5N, Rge. 2W  
(Smallest legal subdivision) (N. or S.) (E. or W.)

or (b) within limits of recorded platted property, town or city:

in Lot \_\_\_\_\_, Block \_\_\_\_\_ of \_\_\_\_\_  
(Name of plat or addition)

County of \_\_\_\_\_  
(If within city or town, give name)

3. Construction Work was begun on June 1947; was completed on Oct. 1947  
(Date) (Date)

and the ground water claimed was first used for the purposes set out below on July 1948  
(Date)

since which time the water has been used intermittently as needed  
(Continuously or intermittently)

from 1948 to 1958  
(Date) (Date)

4. Quantity of water claimed and used is 50 gallons per minute; approx 10 acre feet per year.

5. Purpose or Purposes for which water is used irrigation of apples and filberts  
(Domestic, irrigation, municipal, manufacturing, industrial, etc.)

6. Description of Well: Depth 420 feet. Type drilled  
(Dug or drilled)  
diameter 8 inches. Elevation of ground at well site 250 feet, mean sea level.  
(As near as known)

Depth to water table \_\_\_\_\_ feet. well is artesian. flows to top

7. Capacity of Well: 50 g.p.m. with \_\_\_\_\_ feet drawdown. unknown  
\_\_\_\_\_ g.p.m. with \_\_\_\_\_ feet drawdown.

Date of test \_\_\_\_\_

If Flowing Well: Measured discharge \_\_\_\_\_ g.p.m. on \_\_\_\_\_  
(Date)

Shut-in pressure at ground surface \_\_\_\_\_ lbs. per sq. in. on \_\_\_\_\_  
(Date)

Water is controlled by \_\_\_\_\_  
(Cap, valve, etc.)

8. Casing: (Give diameter, commercial specifications and depth below ground surface of each casing size.)

..... inch diameter ..... from ..... to 60 feet  
..... inch diameter ..... from ..... to ..... feet  
..... inch diameter ..... from ..... to ..... feet  
..... inch diameter ..... from ..... to ..... feet

Describe and show depth of shoe, plug, adapter, liner or other details:  
..... shoe at 60 foot depth  
.....

9. Perforated Casings or Screens:

..... from ..... to .....  
(Number per foot and size of perforations, or describe screen)  
..... from ..... to .....  
..... from ..... to .....  
..... from ..... to .....

10. Log of Well: (Describe each stratum or formation clearly, indicate if water bearing, and give thickness and depth as indicated.)

MATERIAL	Thickness (Feet)	Depth to Bottom (Feet)
clay		
no rock stratum at any level.		

If log of well is not available, give name and address of driller.

McKnight, St. Helens, Oregon

11. Infiltration Trench: Covered or open

Dimensions: Length ft. Minimum depth ft. Maximum depth ft.

Bottom width ft. Discharge g.p.m. Date of test

12. Tunnel: Type of lining

Dimensions: (Length, course, and cross sectional size)

Position of water bearing stratum with reference to portal of tunnel

Log of tunnel: (Preceding table for log of well may be used, if desired. Give footage from portal and character of materials, as pertinent.)

13. Pumping Equipment:

(a) Pump duplex type Capacity g.p.m. (Make, type and size)


(b) Motor 7 1/2 HP and 5 HP (Type and horsepower)

14. Location of area irrigated or to be irrigated, or place of use if for purposes other than irrigation.

Table with 6 columns: Township North or South, Range E. or W. of Willamette Meridian, Section, Forty-acre Tract, Number Acres To Be Irrigated, Date of Reclamation. Contains entries for sections 35 and 36.

15. If the ground water supply is supplemental to an existing water supply, identification of any application for a permit, permit, certificate or adjudicated right to appropriate water made or held by the registrant.

Township 5 N Range 2 W, W.M. 2  
North

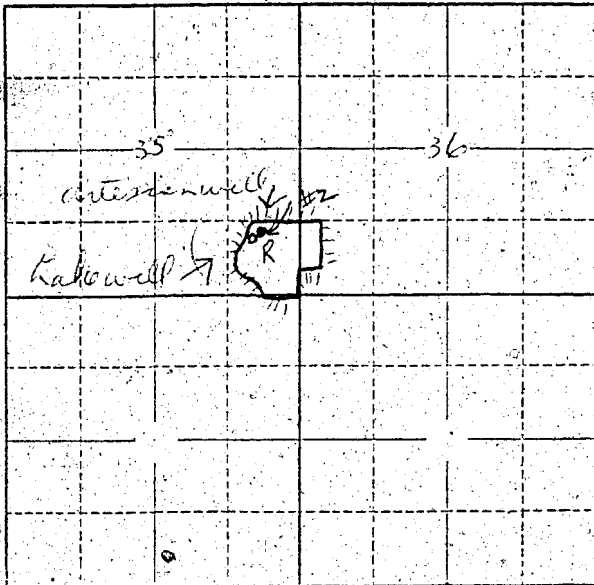

Locate well and acreage of irrigated land on plat.  
Scale: 2" = 1 Mile

STATE OF OREGON

County of COLUMBIA } ss.

I, CARL BRANDENFELS, being first duly sworn, do hereby certify that I have read the foregoing Registration Statement and that all of the items therein contained are true to the best of my knowledge and belief.

Carl Brandenfels  
(Signature of Registrant)

Subscribed and sworn to before me this 28 day of July, 1958

My commission expires Aug 30, 1960

Pauline Brandenfels  
(Notary Public)

(SEAL)

**CERTIFICATE OF REGISTRATION**

STATE OF OREGON

County of Marion } ss.

This is to certify that the foregoing Registration Statement was received in the office of the State Engineer on the 31 day of July, 1958, at 9:00 o'clock A.M. and has been duly recorded in said office in Book No. 19 of Registration Statements on page GR 3248

Witness my hand this 20<sup>th</sup> day of July, 1959

W. H. Stanley  
(State Engineer)

\$15.00

By \_\_\_\_\_ (Deputy)

GR - 3248