

Registration Statement

OF CLAIMANT OF RIGHT TO APPROPRIATE GROUND WATER

TO THE STATE ENGINEER, OF OREGON:

I, William A. Lulay
of Sublimity, Oregon County of Marion
(Mailing address)

State of Oregon, do hereby make application for a certificate of registration as evidence of a right to appropriate ground water.

1. Source from which water is withdrawn is well
(Flowing well, pump well, infiltration trench, or tunnel)

2. Location is: within city limits of Sublimity Oregon (at East city limits)
(Approximate distance and direction from nearest city or town)

and is more particularly described as follows: 96' East and 65' south from the NW Corner of
Sublimity, Oregon described as follows: a 4 acre tract within the city limits of Sublim-
T8S, R1W of Willamette Meridian in Marion County Oregon, running thence West 11.72
chains, thence North 13.25 chains, thence South 10.43 chains, thence West 3.814
and running thence North from said point of beginning a distance of 10.43 chains,
being within (Smallest legal subdivision) of Sec. 17p. (N. or S.) Rge. (E. or W.)
thence running East 3.814 chains, thence South 10.43 chains, thence West 3.814
or (b) within limits of recorded platted property, town or city:
chains to the point of beginning.

in Lot _____, Block _____ of _____
(Name of plat or addition)
County of _____
(If within city or town, give name)

3. Construction Work was begun on 1937; was completed on 1937
(Date) (Date)

and the ground water claimed was first used for the purposes set out below on 1937
(Date)

since which time the water has been used continuously
(Continuously or intermittently)

from 1937 to date
(Date) (Date)

4. Quantity of water claimed and used is 30 gallons per minute; 2 acre
feet per year.

5. Purpose or Purposes for which water is used domestic, stock water and irrigation

(Domestic, irrigation, municipal, manufacturing, industrial, etc.)

6. Description of Well: Depth 222 feet. Type drilled
(Dug or drilled)

diameter 6 inches. Elevation of ground at well site unknown 450 approx feet, mean sea level.
(As near as known)

Depth to water table 60 feet.

7. Capacity of Well: 30 plus g.p.m. with 20 feet drawdown.

_____ g.p.m. with _____ feet drawdown.


Date of test 1937

If Flowing Well: Measured discharge _____ g.p.m. on _____
(Date)

Shut-in pressure at ground surface _____ lbs. per sq. in. on _____
(Date)

Water is controlled by _____
(Cap, valve, etc.)

Township 85 Range 1W W.M.
North

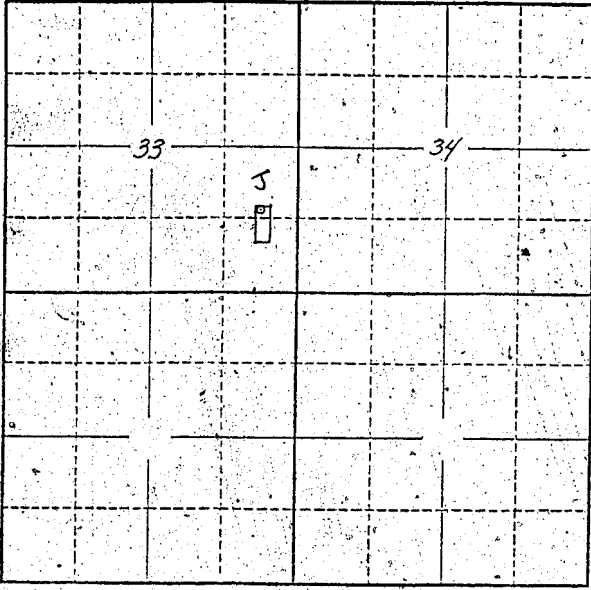

Locate well and acreage of irrigated land on plat.
Scale: 2" = 1 Mile

STATE OF OREGON }
County of Marion } ss.

I, William A. Lulay, being first duly sworn, do hereby certify that I have read the foregoing Registration Statement and that all of the items therein contained are true to the best of my knowledge and belief.

William A. Lulay
(Signature of Registrant)

Subscribed and sworn to before me this 20th day of July, 1958.

My commission expires 11/19/60
(Notary Public)

(SEAL)

CERTIFICATE OF REGISTRATION

STATE OF OREGON }
County of Marion } ss.

This is to certify that the foregoing Registration Statement was received in the office of the State Engineer on the 4th day of August, 1958, at 8:00 o'clock A.M. and has been duly recorded in said office in Book No. 14 of Registration Statements on page GR-3250

Witness my hand this 20th day of July, 1959.

Laura A. Stanley
(State Engineer)

By _____
(Deputy)

4/15.00