

Registration Statement

OF CLAIMANT OF RIGHT TO APPROPRIATE GROUND WATER

TO THE STATE ENGINEER OF OREGON:

Corporation of the Presiding Bishopric
Church of Jesus Christ of Latter Day Saints
I, Salt Lake City, Utah

c/o Corvallis Ward
L. D. S. Church
100 North 27th
Corvallis, Oregon

of 100 North 27th, Corvallis, Oregon
(Mailing address)

County of Benton

State of Oregon do hereby make application for a certificate of registration as evidence of a right to appropriate ground water:

1. Source from which water is withdrawn is Pump Well
(Flowing well, pump well, infiltration trench, or tunnel)

2. Location is: One mile east of Corvallis, Oregon in Linn County
(Approximate distance and direction from nearest city or town)

and is more particularly described as follows: 550 ft. South & 400 feet west from Center of Section 36.

(a) Well located in center of property see legal description attached
(Give distance and bearing to corner of section or other legal subdivision)

being within NE 1/4 of SW 1/4 of Sec. 36, Twp. 11 S, Rge. 5 W
(Smallest legal subdivision) (N. or S.) (E. or W.)

or (b) within limits of recorded platted property, town or city: East Corvallis Acres
Located in

in Lot of Tract 6 and 7 of East Corvallis Acres
(Name of plat or addition)

County of Linn
(If within city or town, give name)

3. Construction Work was begun on in 1918 or 1919; was completed on 1918 or 1919
(Date) (Date)

and the ground water claimed was first used for the purposes set out below on June 1955
(Date)

since which time the water has been used Continuously
(Continuously or Intermittently)

from June 1955 to Present - July 24, 1958
(Date) (Date)

4. Quantity of water claimed and used is 144 gallons per minute; 200 acre feet per year.

5. Purpose or Purposes for which water is used Irrigation

(Domestic, irrigation, municipal, manufacturing, industrial, etc.)

6. Description of Well: Depth 32 feet. Type drilled
(Dug or drilled)

diameter 10 inches. Elevation of ground at well site 200 feet, mean sea level.
(As near as known)

Depth to water table 15 feet.

7. Capacity of Well: 144 g.p.m. with 2 feet drawdown.

g.p.m. with feet drawdown.

Date of test July 10, 1958

If Flowing Well: Measured discharge g.p.m. on
(Date)

Shut-in pressure at ground surface lbs. per sq. in. on
(Date)

Water is controlled by
(Cap, valve, etc.)

8. Casing: (Give diameter, commercial specifications and depth below ground surface of each casing size.)

11 inch diameter from Top to 32 feet
..... inch diameter from to feet
..... inch diameter from to feet
..... inch diameter from to feet

Describe and show depth of shoe, plug, adapter, liner or other details:


9. Perforated Casings or Screens:

(Number per foot and size of perforations, or describe screen) from to
..... from to
..... from to
..... from to

10. Log of Well: (Describe each stratum or formation clearly, indicate if water bearing, and give thickness and depth as indicated.)

MATERIAL	Thickness (Feet)	Depth to Bottom (Feet)
Log of well unknown - drilled for previous owner		

Township 11S Range 5W, W.M.
North

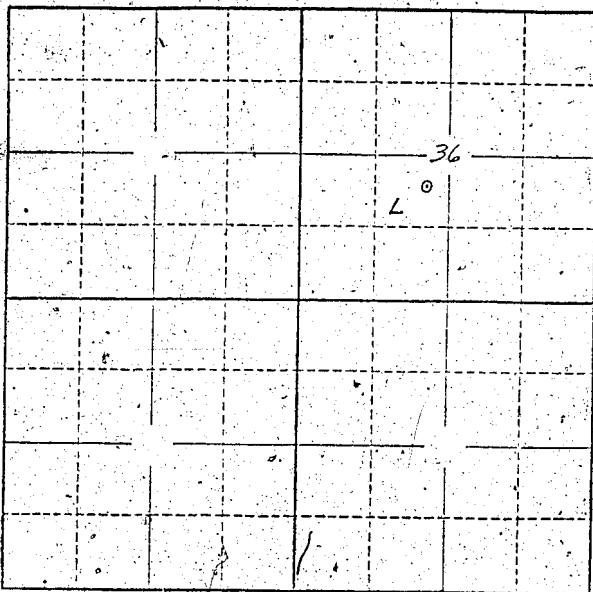

Locate well and acreage of irrigated land on plat.
Scale: 2" = 1 Mile

STATE OF OREGON

County of Linn } ss.

N. Stanley Fagg, Bishop Church of

I, Jesus Christ of Latter Day Saints, being first duly sworn, do hereby certify that I have read the foregoing Registration Statement and that all of the items therein contained are true to the best of my knowledge and belief.

N. Stanley Fagg, Bishop
(Signature of Registrant)

Subscribed and sworn to before me this 24th day of July, 1958.

My commission expires Aug. 11, 1961

Marion Lee Strait
(Notary Public) for Oregon

(SEAL)

CERTIFICATE OF REGISTRATION

STATE OF OREGON

County of Marion } ss.

This is to certify that the foregoing Registration Statement was received in the office of the State Engineer on the 4th day of August, 1958, at 8:00 o'clock A. M. and has been duly recorded in said office in Book No. 14 of Registration Statements on page GR-3253

Witness my hand this 20th day of July, 1959

\$15.00

W. H. [Signature]
(State Engineer)

By _____ (Deputy)

GR-3253