

Registration Statement

OF CLAIMANT OF RIGHT TO APPROPRIATE GROUND WATER

TO THE STATE ENGINEER OF OREGON:

I, Norbert C. Mitchell

of 501 Choring Road (E.P.)

(Mailing address)

County of Lane

State of Oregon, do hereby make application for a certificate of registration as evidence of a right to appropriate ground water.

1. Source from which water is withdrawn is Pump Well

(Flowing well, pump well, infiltration trench, or other)

2. Location is: 6 miles from Eugene or 12 miles from Santa Clara

(Approximate distance and direction from nearest city or town)

and is more particularly described as follows:

(a) South 2534 to well, west 1/2 section road 1/4 E. to north line of 1/2 section with 2534 to well.

(Give distance and bearing to corner of section or other legal subdivision)

being within 1/4 of Sec. 11, Twp. 11, Rge. 11

(Smallest legal subdivision)

(N. or S.)

(E. or W.)

or (b) within limits of recorded platted property, town or city:

in Lot 12, Block Herndale Addition to Santa Clara

(Name of plat or addition)

County of Lane

(If within city or town, give name)

3. Construction Work was begun on June 25-39; was completed on July 15-39

(Date)

(Date)

and the ground water claimed was first used for the purposes set out below on July 20-39

(Date)

since which time the water has been used intermittently

(Continuously or intermittently)

from May 1 to Sept 1

(Date)

(Date)

4. Quantity of water claimed and used is 6000 (100 gpm) gallons per minute, 1/2 acre feet per year.

5. Purpose or Purposes for which water is used irrigating various kinds

of farm crops

(Domestic, irrigation, municipal, manufacturing, industrial, etc.)

6. Description of Well: Depth 176 feet. Type Key well

(Dug or drilled)

diameter 5 1/2 ft square inches. Elevation of ground at well site 22 feet, mean sea level.

(As near as known)

Depth to water table 12 feet.

7. Capacity of Well: 700 g.p.m. with 10 feet drawdown.

g.p.m. with

feet drawdown.

Date of test

If Flowing Well: Measured discharge 700 g.p.m. on

(Date)


Shut-in pressure at ground surface 22 lbs. per sq. in. on

(Date)

Water is controlled by

(Cap, valve, etc.)

Township 17s Range 4w, W.M.
North

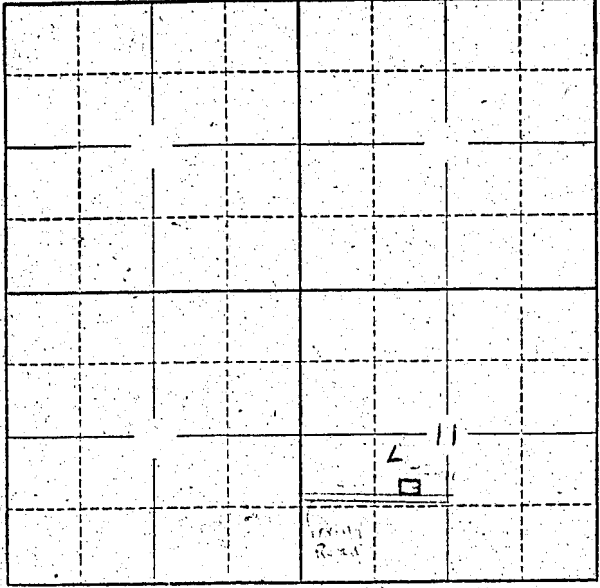

LOT 12
7 Acres, 10 Cents
1611 1/2 Road

Locate well and acreage of irrigated land on plat.
Scale: 2" = 1 Mile

STATE OF OREGON

County of Lane } ss.

I, Herbert A. Metcalf, being first duly sworn, do hereby certify that I have read the foregoing Registration Statement and that all of the items therein contained are true to the best of my knowledge and belief.

Herbert A. Metcalf
(Signature of Registrant)

Subscribed and sworn to before me this 30th day of July, 1959.

My commission expires Aug. 25 1961
(Notary Public)

(SEAL)

CERTIFICATE OF REGISTRATION

STATE OF OREGON

County of Marion } ss.
Lane

This is to certify that the foregoing Registration Statement was received in the office of the State Engineer on the 4th day of August, 1959, at 8:00 o'clock A. M. and has been duly recorded in said office in Book No. 14 of Registration Statements on page GR-3255.

Witness my hand this 20th day of July, 1959

Lewis A. Stanley
(State Engineer)

By _____ (Deputy)

\$15.00

GR-3255