

RECEIVED
JUL 30 1958
STATE ENGINEER
SALE

REGISTRATION NO. GR-3538
CERTIFICATE NO. GR-4075

Registration Statement

OF CLAIMANT OF RIGHT TO APPROPRIATE GROUND WATER

(Under Chapter 708, Oregon Laws 1955.)

TO THE STATE ENGINEER OF OREGON:

I, WILLIAM MICHAEL BYERLEY

of McMINNVILLE RT 2 BOX 144 County of YAMHILL

State of OREGON, do hereby make application for a certificate of registration as evidence of a right to appropriate ground water.

1. Source from which water is withdrawn is Deep Well
(Flowing well, pump well, infiltration trench, or tunnel)

2. Location is: 3 MILES NORTH OF McMINNIVILLE, OREGON
(Approximate distance and direction from nearest city or town)

and is more particularly described as follows: FROM NORTH EAST CORNER 135 FEET SOUTH THENCE 79 FEET WEST 1970 feet west E 1540 feet north from SE Corner Sect 11

(a) 77 W. of 2 N.P. at S.E. Cor. Sec. 2, T. 4 S., R. 4 W., S. 11 Said 1/2 being sit. by U.S. For Reservoir Unit 59
(Give distance and bearing to corner of section or other legal subdivision)
being within NW 1/4 of SE 1/4 of Sec. 11, Twp. 4 S., Rge. 4 W.
(Smallest legal subdivision) (S. or W.)

or (b) within limits of recorded platted property, town or city: _____

in Lot _____, Block _____ of _____
(Name of plat or addition)

County of YAMHILL
(If within city or town, give name)

3. Construction Work was begun on Apr. 7, 1954; was completed on Apr. 14, 1954
(Date) (Date)

and the ground water claimed was first used for the purposes set out below on Apr. 20, 1954
(Date)

since which time the water has been used Continuously for domestic purposes
(Continuously or intermittently)
from THEN 1954 to NOW 1958
(Date) (Date)
for 3. inter. for irrigation

4. Quantity of water claimed and used is 15 gallons per minute; _____ acre feet per year.

5. Purpose or Purposes for which water is used Domestic & Irrigation
(Domestic, irrigation, municipal, manufacturing, industrial, etc.)

6. Description of Well: Depth 21 feet. Type Drilled
(Dug or drilled)

diameter 6 inches. Elevation of ground at well site _____ feet, mean sea level.
(As near as known)

Depth to water table _____ feet.

7. Capacity of Well: 30 g.p.m. with 60 feet drawdown.
_____ g.p.m. with _____ feet drawdown.


Date of test Apr. 14, 1954

If Flowing Well: Measured discharge _____ g.p.m. on _____
(Date)

Shut-in pressure at ground surface _____ lbs. per sq. in. on _____
(Date)

Water is controlled by _____
(Cap, valve, etc.)

Township 45 Range 4W, W.M.
North

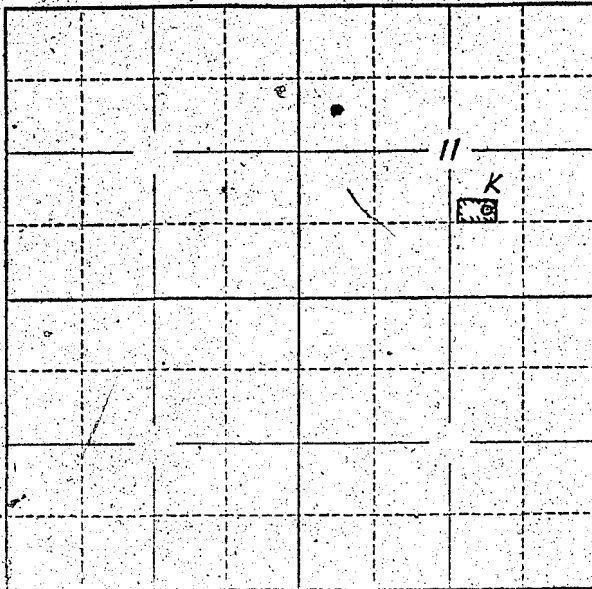

Locate well and acreage of irrigated land on plat.
Scale: 2" = 1 Mile

STATE OF OREGON

County of Yamhill

} ss.

I, Mrs. Charles Stoudt, being first duly sworn, do hereby certify that I have read the foregoing Registration Statement and that all of the items therein contained are true to the best of my knowledge and belief.

new owners

Mrs. Charles Stoudt

(Signature of Registrant)

Subscribed and sworn to before me this 18 day of April, 1960.

My commission expires Jan. 26, 1963

Bernice E. Pearson
(Notary Public)

(SEAL)

CERTIFICATE OF REGISTRATION

STATE OF OREGON

County of Marion

} ss.

This is to certify that the foregoing Registration Statement was received in the office of the State Engineer on the 4th day of August, 1958, at 8:00 o'clock A. M. and has been duly recorded in said office in Book No. 17 of Registration Statements on page GR-4075

~~Construction shall be completed by 1959 and the water completely open for beneficial use by 1959~~

Witness my hand this 16th day of May, 1960.

LEWIS A. STANLEY

(State Engineer)

By

Max F. Rogers

(Deputy)

GR 4075

\$15.00