

Registration Statement

GR-3539
GR-3256

OF CLAIMANT OF RIGHT TO APPROPRIATE GROUND WATER

(Under Chapter 708, Oregon Laws 1955.)

TO THE STATE ENGINEER OF OREGON:

I, Dale Herzig, 4920 Silverton Rd
of Salem County of Marian

State of Oregon, do hereby make application for a certificate of registration as evidence of a right to appropriate ground water.

- 1. Source from which water is withdrawn is Tump Well
(Flowing well, pump well, infiltration trench, or tunnel)
- 2. Location is: 5 Miles East of Salem
(Approximate distance and direction from nearest city or town)

and is more particularly described as follows:

(a) S. 75° 44' E 639.70 Feet from NW corner Section 17
(Give distance and bearing to corner of section or other legal subdivision)
being within NW 1/4 of NW 1/4 of Sec. 17, Twp. 7, Rge. 2
(Smallest legal subdivision) (N. or S.) (E. or W.)

or (b) within limits of recorded platted property, town or city:
in Lot _____, Block _____ of _____
(Name of plat or addition)

County of Marian
(If within city or town, give name)

3. Construction Work was begun on Aug 1948; was completed on Oct 1948
(Date) (Date)
and the ground water claimed was first used for the purposes set out below on Sept 1948
(Date)

since which time the water has been used Continuously
(Continuously or Intermittently)
from Sept 1948 to July 1958
(Date) (Date)

4. Quantity of water claimed and used is 10 gallons per minute; 3 acre feet per year.

5. Purpose or Purposes for which water is used Irrigation of 50 Acres of Stock
(Domestic, irrigation, municipal, manufacturing, industrial, etc.)

6. Description of Well: Depth 5 feet. Type Drilled
(Dug or drilled)
diameter 6 inches. Elevation of ground at well site _____ feet, mean sea level.
(As near as known)
Depth to water table 20 feet.

7. Capacity of Well: 20 g.p.m. with 2 feet drawdown.
_____ g.p.m. with _____ feet drawdown.


Date of test Aug 1948

If Flowing Well: Measured discharge _____ g.p.m. on _____
(Date)

Shut-in pressure at ground surface _____ lbs. per sq. in. on _____
(Date)

Water is controlled by _____
(Cap, valve, etc.)

Township 7 S Range 2 W W.M.
North

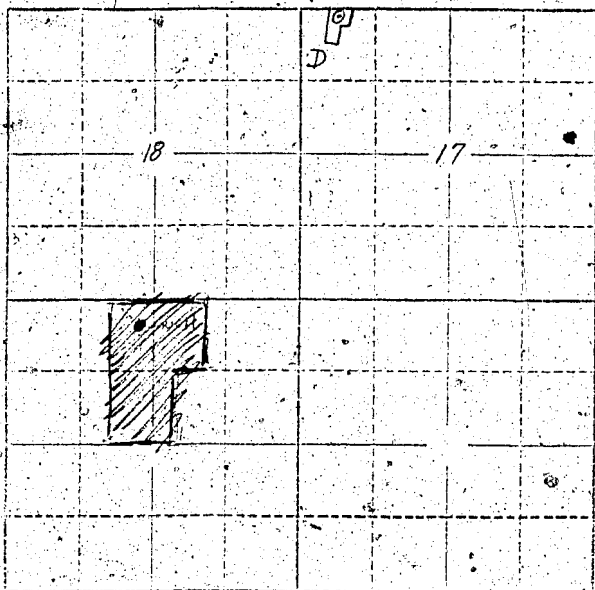

Locate well and acreage of irrigated land on plat.
Scale: 2" = 1 Mile

STATE OF OREGON

County of Marion } ss.

I, Paul Herigstad, being first duly sworn, do hereby certify that I have read the foregoing Registration Statement and that all of the items therein contained are true to the best of my knowledge and belief.

Paul Herigstad
(Signature of Registrant)

Subscribed and sworn to before me this 30th day of July, 1958.

My commission expires _____
Harry J. Reed
(Notary Public)

(SEAL)

CERTIFICATE OF REGISTRATION

STATE OF OREGON } ss.
County of Marion

This is to certify that the foregoing Registration Statement was received in the office of the State Engineer on the 1st day of August, 1958 at 8:00 o'clock A. M. and has been duly recorded in said office in Book No. 14 of Registration Statements on page GR-3256

~~Construction shall be completed by _____ and the water completely applied by _____~~

Witness my hand this 20th day of July, 1959

Paul A. Stanley
(State Engineer)

\$15.00

By _____ (Deputy)
GR-3256