

Registration Statement

OF CLAIMANT OF RIGHT TO APPROPRIATE GROUND WATER

TO THE STATE ENGINEER OF OREGON:

I, WILLIAM MCCARTY AND ESSIE MCCARTY

of 2419 TABLE ROCK ROAD WILDFORD, OREGON County of WASHINGTON

State of OREGON do hereby make application for a certificate of registration as evidence of a right to appropriate ground water.

1. Source from which water is withdrawn is PUMP WELL
(Flowing well, pump well, infiltration trench, or tunnel)

2. Location is: 2 MILES NORTH OF WILDFORD, OREGON
(Approximate distance and direction from nearest city or town)

and is more particularly described as follows: 3717 FEET WEST AND 760 FEET NORTH OF THE SOUTHWEST CORNER OF DONATION LAND CLAIM # 39 IN TOWNSHIP 37 SOUTH, RANGE 1 WEST OF THE WILLAMETTE

(a) NW 1/4 of S.E. 1/4 being within of Sec. 17, Twp. 37 SOUTH, Rge. 2
(Smallest legal subdivision) (N. or S.) (E. or W.)

or (b) within limits of recorded platted property, town or city:

in Lot _____ Block _____ of _____
(Name of plat or addition)

County of _____
(If within city or town, give name)

3. Construction Work was begun on APPROXIMATELY 1943; was completed on 3-1943
(Date) (Date)

and the ground water claimed was first used for the purposes set out below on 1943
(Date)

since which time the water has been used CONTINUOUSLY FOR IRRIGATION
(Continuously or intermittently)

from _____ to _____
(Date) (Date)

4. Quantity of water claimed and used is 30 gallons per minute; _____ acre feet per year.

5. Purpose or Purposes for which water is used IRRIGATION

(Domestic, irrigation, municipal, manufacturing, industrial, etc.)

6. Description of Well: Depth 15 feet. Type 300
(Dug or drilled)

diameter 72 inches. Elevation of ground at well site 1300 feet, mean sea level.
(As near as known)

Depth to water table _____ feet

7. Capacity of Well: 40 g.p.m. with _____ feet drawdown.

60 g.p.m. with _____ feet drawdown.

Date of test 3-1943


If Flowing Well: Measured discharge _____ g.p.m. on _____
(Date)

Shut-in pressure at ground surface _____ lbs. per sq. in. on _____
(Date)

Water is controlled by _____
(Cap, valve, etc.)

Township 37S Range 2W, W.M.

R 2 North R 1

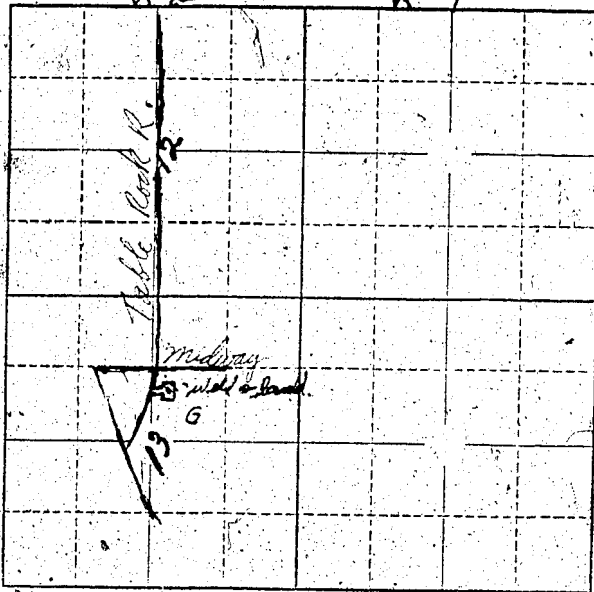

Locate well and acreage of irrigated land on plat.

Scale: 2" = 1 Mile

STATE OF OREGON

County of Jackson } ss.

I, _____, being first duly sworn, do hereby certify that I have read the foregoing Registration Statement and that all of the items therein contained are true to the best of my knowledge and belief.

(Signature of Registrant)

Subscribed and sworn to before me this _____ day of _____, 19____.

My commission expires _____
(Notary Public)

(SEAL)

CERTIFICATE OF REGISTRATION

STATE OF OREGON

County of Marion } ss.

This is to certify that the foregoing Registration Statement was received in the office of the State Engineer on the 4th day of August, 1958, at 8:00 o'clock A.M. and has been duly recorded in said office in Book No. 14 of Registration Statements on page GR-3257

Witness my hand this 20th day of July, 1959.

(State Engineer)

By _____
(Deputy)

GR-3257

4/5-00