

# Registration Statement

## OF CLAIMANT OF RIGHT TO APPROPRIATE GROUND WATER

TO THE STATE ENGINEER OF OREGON:

I, Joseph L. Veal  
of K. E. L. Ex. 22A, Eugene County of Polk  
(Mailing address)  
State of Oregon, do hereby make application for a certificate of registration as evidence of a right to appropriate ground water.

1. Source from which water is withdrawn is 9' pump well  
(Flowing well, pump well, infiltration trench, or tunnel)

2. Location is: 1/2 mile from NW 1/4  
(Approximate distance and direction from nearest city or town)

and is more particularly described as follows:

(a) 2250' S 1100' E of NW 1/4  
(Give distance and bearing to corner of section or other legal subdivision)

being within SW 1/4 NW 1/4 of Sec. 2, Twp. 8 S, Rge. 4 W  
(Smallest legal subdivision) (or S.) (or W.)

or (b) within limits of recorded platted property, town or city:

in Lot \_\_\_\_\_ Block \_\_\_\_\_ of \_\_\_\_\_  
(Name of plat or addition)  
(If within city or town, give name)

3. Construction Work was begun on 1952; was completed on 1952  
(Date) (Date)

and the ground water claimed was first used for the purposes set out below on April 1952  
(Date)

since which time the water has been used intermittently  
(Continuously or Intermittently)

from 1952 to 1954  
(Date) (Date)

4. Quantity of water claimed and used is 75 gallons per minute; 32 acre feet per year.

5. Purpose or Purposes for which water is used irrigation

(Domestic, irrigation, municipal, manufacturing, industrial, etc.)

6. Description of Well: Depth 50 feet. Type drilled  
(Dug or drilled)

diameter 3 inches. Elevation of ground at well site \_\_\_\_\_ feet, mean sea level.  
(As near as known)

Depth to water table 40 feet:

7. Capacity of Well: 75 g.p.m. with 3 feet drawdown.

\_\_\_\_\_ g.p.m. with \_\_\_\_\_ feet drawdown.

Date of test Apr 1952

If Flowing Well: Measured discharge \_\_\_\_\_ g.p.m. on \_\_\_\_\_  
(Date)


Shut-in pressure at ground surface \_\_\_\_\_ lbs. per sq. in. on \_\_\_\_\_  
(Date)

Water is controlled by \_\_\_\_\_  
(Cap, valve, etc.)





Township 8 S Range 4 W W.M. North

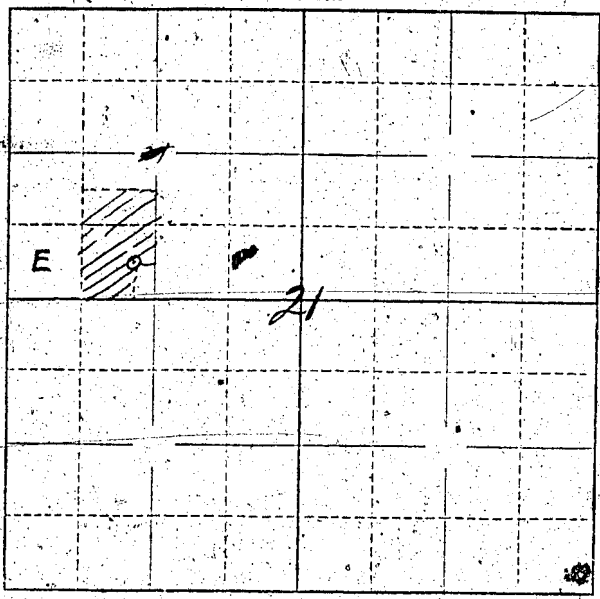

Locate well and acreage of irrigated land on plat.  
Scale: 2" = 1 Mile

STATE OF OREGON }  
County of Polk } ss.

X I, Stacy M. Wash, being first duly sworn, do hereby certify that I have read the foregoing Registration Statement and that all of the items therein contained are true to the best of my knowledge and belief.

[Signature]  
(Signature of Registrant)

Subscribed and sworn to before me this 21 day of July, 1959

My commission expires MY COMMISSION EXPIRES APRIL 30, 1962  
[Signature]  
(Notary Public)

(SEAL)

**CERTIFICATE OF REGISTRATION**

STATE OF OREGON }  
County of Marion } ss.

This is to certify that the foregoing Registration Statement was received in the office of the State Engineer on the 21 day of July, 1959, at 11 o'clock A.M. and has been duly recorded in said office in Book No. 14 of Registration Statements on page GR-3261

Witness my hand this 20 day of July, 1959

[Signature]  
(State Engineer)

By \_\_\_\_\_  
(Deputy)

GR-3261

\$15.00