

Registration Statement

OF CLAIMANT OF RIGHT TO APPROPRIATE GROUND WATER

TO THE STATE ENGINEER OF OREGON:

I, LUIS M. MEYER
of 165 Myrtle Road EUGENE County of Lane
(Mailing address)

State of Oregon, do hereby make application for a certificate of registration as evidence of a right to appropriate ground water.

1. Source from which water is withdrawn is Pump Well
(Flowing well, pump well, infiltration trench, or tunnel)

2. Location is: 3 miles north of Eugene Oregon
(Approximate distance and direction from nearest city or town)

and is more particularly described as follows:

25.75 Chain + 516.51' W and 1508' N from NE Cor. C.W. Young D.L.C #53,

(a) 1200 feet east & 900 feet south from NW corner Section 20.
(Give distance and bearing to corner of section or other legal subdivision)

being within Northwest 1/4 NW 1/4 of Sec. 20, Twp. 17S, Rge. 3W
(Smallest legal subdivision) or S. or W.

or (b) within limits of recorded platted property, town or city:

in Lot _____, Block _____ of _____
(Name of plat or addition)

County of LANE
(If within city or town, give name)

3. Construction Work was begun on 6-20-1938, was completed on 6-21-1938
(Date) (Date)

and the ground water claimed was first used for the purposes set out below on 6-25-1938
(Date)

since which time the water has been used continuously
(Continuously or intermittently)

from APRIL 1938 to OCT 1938
(Date) (Date)

4. Quantity of water claimed and used is 32 gallons per minute; _____ acre-feet per year.

5. Purpose or Purposes for which water is used Domestic

Domestic, irrigation, municipal, manufacturing, industrial, etc.

6. Description of Well: Depth 20 feet. Type Drum Well
(Dug or drilled)

diameter 1 1/2 inches. Elevation of ground at well site 410 feet, mean sea level.
(As near as known)

Depth to water table 10 to 17 feet. in winter less than 10' at times

7. Capacity of Well: 32 g.p.m. with 2 feet drawdown. Never Pumped Dry

_____ g.p.m. with _____ feet drawdown.

Date of test 1944

If Flowing Well: Measured discharge _____ g.p.m. on _____
(Date)

Shut-in pressure at ground surface _____ lbs. per sq. in. on _____
(Date)

Water is controlled by _____
(Cap, valve, etc.)

8. Casing: (Give diameter, commercial specifications and depth below ground surface of each casing size.)

1 1/2 inch diameter from to 20 feet

..... inch diameter from to feet

..... inch diameter from to feet

..... inch diameter from to feet

Describe and show depth of shoe, plug, adapter, liner or other details:

9. Perforated Casings or Screens:

600 ft. screen from to

(Number per foot and size of perforations, or describe screen)

..... from to

..... from to

..... from to

10. Log of Well: (Describe each stratum or formation clearly, indicate if water bearing, and give thickness and depth as indicated.)

MATERIAL	Thickness (Feet)	Depth to Bottom (Feet)
.....		
.....		
If log of well is not available, give name and address of driller.

11. Infiltration Trench: Covered or open
Dimensions: Length ft. Minimum depth ft. Maximum depth ft.

Bottom width ft. Discharge g.p.m. Date of test

12. Tunnel: Type of lining

Dimensions: (Length, course, and cross sectional size)

Position of water bearing stratum with reference to portal of tunnel

Log of tunnel: (Preceding table for log of well may be used, if desired. Give footage from portal and character of materials, as pertinent.)

13. Pumping Equipment:

(a) Pump Capacity g.p.m.
(Make, type and size)


(b) Motor
(Type and horsepower)

14. Location of area irrigated or to be irrigated, or place of use if for purposes other than irrigation.

Township North or South	Range E. or W. of Willamette Meridian	Section	Forty-acre Tract ¹	Number Acres To Be Irrigated	Date of Reclamation
T. 17S	R. 3W	20	NW 1/4 of NW 1/4	2 1/2 ac	1938

15. If the ground water supply is supplemental to an existing water supply, identification of any application for a permit, permit, certificate or adjudicated right to appropriate water made or held by the registrant.

Township 17S Range 3W, W.M.
North

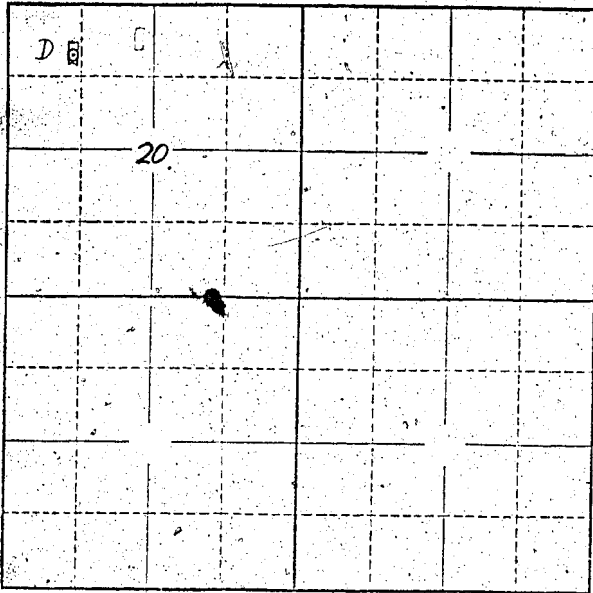

Locate well and acreage of irrigated land on plat.
Scale: 2" = 1 Mile

STATE OF OREGON

County of _____ } ss.

I, _____, being first duly sworn, do hereby certify that I have read the foregoing Registration Statement and that all of the items therein contained are true to the best of my knowledge and belief.

(Signature of Registrant)

Subscribed and sworn to before me this _____ day of _____, 19____.

My commission expires _____

(Notary Public)

(SEAL)

CERTIFICATE OF REGISTRATION

STATE OF OREGON

County of Marion } ss.

This is to certify that the foregoing Registration Statement was received in the office of the State Engineer on the _____ day of _____, 19____, at _____ o'clock _____ M. and has been duly recorded in said office in Book No. 14 of Registration Statements on page GR-3267.

Witness my hand this 20th day of July, 1959.

(State Engineer)

By _____
(Deputy)

GR-3267

15.00