

RECEIVED
FEB 21 1957
STATE ENGINEER
SALEM, OREGON

REGISTRATION NO. GR-356

Registration Statement CERTIFICATE NO. GR 346

OF CLAIMANT OF RIGHT TO APPROPRIATE GROUND WATER

(Under Chapter 708, Oregon Laws 1955.)

TO THE STATE ENGINEER OF OREGON:

I, S. P. Swift, 73 1/2 N. Cottage Street

of Salem County of Marion

State of Oregon, do hereby make application for a certificate of registration as evidence of a right to appropriate ground water.

1. Source from which water is withdrawn is Pump Well
(Flowing well, pump well, infiltration trench, or tunnel)

2. Location is: Approximately 8 miles North of Salem
(Approximate distance and direction from nearest city or town)

and is more particularly described as follows:

(a) 892 Ft East and 21 Ft. South of Center of Section 25
(Give distance and bearing to corner of section or other legal subdivision)

being within NW 1/4 Sec 25 of Sec. 25, Twp. 6 S., Rge. 37
(Smallest legal subdivision) (N. or S.) (E. or W.)

or (b) within limits of recorded platted property, town or city:

in Lot _____, Block _____ of _____
(Name of plat or addition)

County of Marion
(If within city or town, give name)

3. Construction Work was begun on Feb. 20, 1951; was completed on Mar. 5, 1951
(Date) (Date)

and the ground water claimed was first used for the purposes set out below on June 30, 1951
(Date)

since which time the water has been used during irrigation season
(Continuously or intermittently)

from June 1951 to Sept. 1, 1956
(Date) (Date)

4. Quantity of water claimed and used is 100 gallons per minute; 3 ft. acre feet per year.

5. Purpose or Purposes for which water is used Irrigation

(Domestic, irrigation, municipal, manufacturing, industrial, etc.)

6. Description of Well: Depth 102 feet. Type drilled
(Dug or drilled)

diameter 8 1/4 inches. Elevation of ground at well site 150 feet, mean sea level.
(As near as known)

Depth to water table 29 feet.

7. Capacity of Well: 100 g.p.m. with 6 feet drawdown.

150 g.p.m. with 16 feet drawdown.

Date of test March 25, 1951

If Flowing Well: Measured discharge _____ g.p.m. on _____ (Date)

Shut-in pressure at ground surface _____ lbs. per sq. in. on _____ (Date)

Water is controlled by _____
(Cap, valve, etc.)

8. Casing: (Give diameter, commercial specifications and depth below ground surface of each casing size.)

8 inch diameter Standard Casing from to feet
 inch diameter from to feet
 inch diameter from to feet
 inch diameter from to feet

Describe and show depth of shoe, plug, adapter, liner or other details:

9. Perforated Casings or Screens:

See driller from to
(Number per foot and size of perforations, or describe screen)
 from to
 from to
 from to

10. Log of Well: (Describe each stratum or formation clearly, indicate if water bearing, and give thickness and depth as indicated.)

| See driller | MATERIAL | Thickness (Feet) | Depth to Bottom (Feet) |
|-------------|----------|---------------------|---------------------------|
| | | | |
| | | | |
If log of well is not available, give name and address of driller Max Wymore

11. Infiltration Trench: Covered or open

Dimensions: Length ft. Minimum depth ft. Maximum depth ft.

Bottom width ft. Discharge g.p.m. Date of test

12. Tunnel: Type of lining

Dimensions:
(Length, course, and cross sectional size)

Position of water bearing stratum with reference to portal of tunnel

Log of tunnel? (Preceding table for log of well may be used, if desired. Give footage from portal and character of materials, as pertinent.)

13. Pumping Equipment:

(a) Pump Jacuzzi 1/2" Lineshaft turbine Capacity 100 g.p.m.
(Make, type and size)


(b) Motor 5 HP
(Type and horsepower)

14. Location of area irrigated or to be irrigated, or place of use if for purposes other than irrigation.

| Township North or South | Range E. or W. of Willamette Meridian | Section | Forty-acre Tract | Number Acres To Be Irrigated | Date of Reclamation |
|-------------------------|---------------------------------------|---------|------------------|------------------------------|---------------------|
| T 6 S | R 3 W | 25 | NE 1/4 SE 1/4 | 8.67 | 1951 |
| T 6 S | R 3 W | 25 | NE 1/4 SW 1/4 | 4 | 1951 |
| | | | | 12.67 | |
| | | | | | |
| | | | | | |
15. If the ground water supply is supplemental to an existing water supply, identification of any application for a permit, permit, certificate or adjudicated right to appropriate water made or held by the registrant.

Sec. 25 Township 6 S Range 3 W W.M.
North

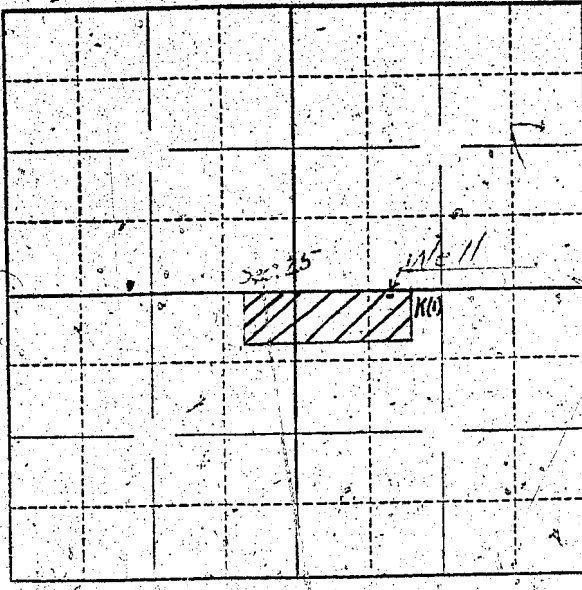

Locate well and acreage of irrigated land on plat.

Scale: 1/4" = 1 Mile

STATE OF OREGON

County of MARION } ss.

I, SAMUEL P. SWIFT, being first duly sworn, do hereby certify that I have read the foregoing Registration Statement and that all of the items therein contained are true to the best of my knowledge and belief.

Samuel P. Swift
(Signature of Registrant)

Subscribed and sworn to before me this 31st day of JANUARY, 1957.

My commission expires AUGUST 20, 1960.

O. P. Eckersley
(Notary Public)

(SEAL)

CERTIFICATE OF REGISTRATION

STATE OF OREGON

County of Marion } ss.

This is to certify that the foregoing Registration Statement was received in the office of the State Engineer on the 5th day of February, 1957, at 8:00 o'clock A.M. and has been duly recorded in said office in Book No. 2 of Registration Statements on page GR-316 C.

Witness my hand this 30th day of April, 1957.

Lewis A. Stanley
(State Engineer)

By _____ (Deputy)

\$15.00

GR 316 C