

# Registration Statement

## OF CLAIMANT OF RIGHT TO APPROPRIATE GROUND WATER

(Under Chapter 708, Oregon Laws 1955.)

### TO THE STATE ENGINEER OF OREGON:

I, Frank H. Savage

of Route #1, Box 196B, Eugene, County of Lane

State of Oregon, do hereby make application for a certificate of registration as evidence of a right to appropriate ground water.

- 1. Source from which water is withdrawn is Pump well  
(Flowing well, pump well, infiltration trench, or tunnel)
- 2. Location is: Approx. 5 miles North of Eugene and 1/8 miles West of 99 Highway  
(Approximate distance and direction from nearest city or town)

and is more particularly described as follows:

The location of the well is 1165 ft. North of the S.E. corner of  
(a) Sect. 5 T17S R4 W.W.M. and 66 ft. West of the West line of Bird Station Road.  
(Give distance and bearing to corner of section or other legal subdivision)

being within the N/4 of the S/4 of the S/4 of Sec. 5, Twp. 17S, Rge. 4W  
(Smallest legal subdivision) (N. or S.) (E. or W.)

or (b) within limits of recorded platted property, town or city: \_\_\_\_\_

in Lot \_\_\_\_\_ Block \_\_\_\_\_ of \_\_\_\_\_  
(Name of plat or addition)

County of \_\_\_\_\_  
(If within city or town, give name)

- 3. Construction Work was begun on August 1952; was completed on August 1952  
(Date) (Date)

and the ground water claimed was first used for the purposes set out below on August 1952  
(Date)

since which time the water has been used intermittently as needed for irrigation  
(Continuously or intermittently)

from August 1952 to July 31 1958  
(Date) (Date)

- 4. Quantity of water claimed and used is 105 gallons per minute; \_\_\_\_\_ acre feet per year.

- 5. Purpose or Purposes for which water is used Irrigation and ~~potable~~

(Domestic, irrigation, municipal, manufacturing, etc.)

- 6. Description of Well: Depth 46 feet. Type Drilled

(Dug or drilled)

diameter \_\_\_\_\_ inches. Elevation of ground at well site 365 feet, mean sea level.  
(As near as known)

Depth to water table 10 feet.

- 7. Capacity of Well: 105 g.p.m. with 10 feet drawdown, pumping this amount \_\_\_\_\_ g.p.m. with \_\_\_\_\_ feet drawdown.

Date of test August 1952

If Flowing Well: Measured discharge \_\_\_\_\_ g.p.m. on \_\_\_\_\_


Shut-in pressure at ground surface \_\_\_\_\_ lbs. per sq. in. on \_\_\_\_\_

Water is controlled by \_\_\_\_\_  
(Name, valve, etc.)





Sect. 5 Township 17S Range 4W W.M.  
North

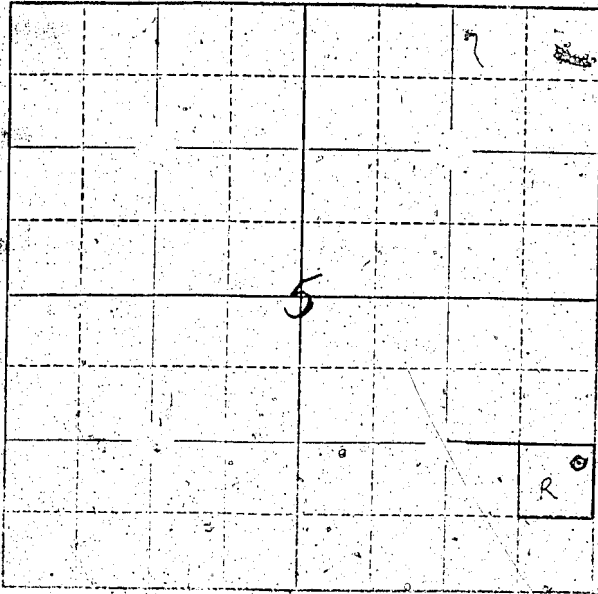

Locate well and acreage of irrigated land on plat.

Scale: 4" = 1 Mile  
4"

STATE OF OREGON

County of LANE

I, Frank N. Savage, being first duly sworn, do hereby certify that I have read the foregoing Registration Statement and that all of the items therein contained are true to the best of my knowledge and belief.

(Signature of Registrant)

Subscribed and sworn to before me this 31st day of July, 1958.

My commission expires

(Notary Public)

(SEAL)

### CERTIFICATE OF REGISTRATION

STATE OF OREGON

County of Marion

This is to certify that the foregoing Registration Statement was received in the office of the State Engineer on the \_\_\_\_\_ day of \_\_\_\_\_, 19\_\_\_\_, at \_\_\_\_\_ o'clock \_\_\_\_\_ M. and has been duly recorded in said office in Book No. 14 of Registration Statements on page GR-3278.

Construction shall be completed by \_\_\_\_\_ and the water completely applied to beneficial use by \_\_\_\_\_ 19\_\_\_\_.

Witness my hand this \_\_\_\_\_ day of July, 1958.

(State Engineer)

By

(Deputy)

GR-3278