

Registration Statement

OF CLAIMANT OF RIGHT TO APPROPRIATE GROUND WATER

TO THE STATE ENGINEER OF OREGON:

I, HOYT CUPP

of Rt. 5, Box 153, Salem, County of Marion
(Mailing address)

State of Oregon, do hereby make application for a certificate of registration as evidence of a right to appropriate ground water.

1. Source from which water is withdrawn is dug hole
(Flowing well, pump well, infiltration trench, or tunnel)

2. Location is: one-half mile North of Aumsville, Oregon.
(Approximate distance and direction from nearest city or town)

and is more particularly described as follows:

(a) App. 500 ft. from the NW corner of Cupp land by deed recorded in Volume 355
(Give distance and bearing to corner of section or other legal subdivision)
Page 132, Marion County Records
being within West half of NE 1/4 SW 1/4 of Sec. 25, Twp. 8 South, Rge. 2 West
(Smallest legal subdivision) (N. or S.) (E. or W.)

or (b) within limits of recorded platted property, town or city:

in Lot _____, Block _____ of _____
(Name of plat or addition)

County of _____
(If within city or town, give name)

3. Construction Work was begun on 1945; was completed on 1946
(Date) (Date)

and the ground water claimed was first used for the purposes set out below on 1946
(Date)

since which time the water has been used intermittently
(Continuously or intermittently)

from 1946 to present 1958
(Date) (Date)

4. Quantity of water claimed and used is 80 gallons per minute; _____ acre feet per year.

5. Purpose or Purposes for which water is used irrigation

(Domestic, irrigation, municipal, manufacturing, industrial, etc.)

6. Description of hole Depth 21 feet. Type dug
(Dug or drilled)

diameter 8 ft. ~~XXXXXX~~ Elevation of ground at well site _____ feet, mean sea level.
(As near as known)

Depth to water table _____ feet.

7. Capacity of Well: No test g.p.m. with _____ feet drawdown.

_____ g.p.m. with _____ feet drawdown.


Date of test _____

If Flowing Well: Measured discharge _____ g.p.m. on _____
(Date)

Shut-in pressure at ground surface _____ lbs. per sq. in. on _____
(Date)

Water is controlled by _____
(Cap, valve, etc.)

Township 8 South Range 2 West W.M.
North

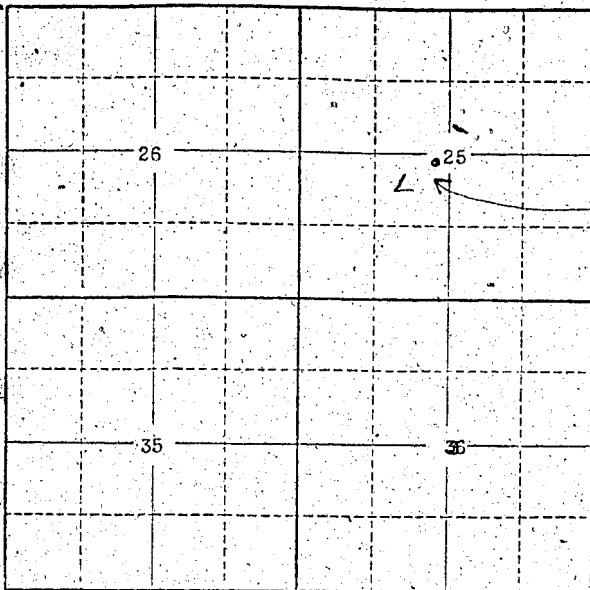

WELL
SEE ATTACHED
MAP FOR IRRIGATION
AREA

Locate well and acreage of irrigated land on plat.
Scale: 2" = 1 Mile

STATE OF OREGON

County of Marion

ss.

I, HOYT CUEP, being first duly sworn, do hereby certify that I have read the foregoing Registration Statement and that all of the items therein contained are true to the best of my knowledge and belief.

Hoyt Cuep
(Signature of Registrant)

Subscribed and sworn to before me this 31st day of July, 1958

My commission expires Sept. 20, 1959

George R. ...
(Notary Public for Oregon)

(SEAL)

CERTIFICATE OF REGISTRATION

STATE OF OREGON

County of Marion

ss.

This is to certify that the foregoing Registration Statement was received in the office of the State Engineer on the 1 day of August, 1958 at 9:30 o'clock A.M. and has been duly recorded in said office in Book No. 14 of Registration Statements on page GR 3278

Witness my hand this 22nd day of July, 1958

Mrs. H. ...
(State Engineer)

\$15.00

By _____ (Deputy)

GR - 3278