

OF CLAIMANT OF RIGHT TO APPROPRIATE GROUND WATER

(Under Chapter 708, Oregon Laws 1955.)

TO THE STATE ENGINEER OF OREGON:

I, A. W. Denney

of 2995 Madrona Lane, Medford, Oregon, County of Jackson

State of Oregon, do hereby make application for a certificate of registration as evidence of a right to appropriate ground water.

1. Source from which water is withdrawn is Infiltration Trench
(Flowing well, pump well, infiltration trench, or tunnel)

2. Location is: approximately 2 miles West of Medford, Oregon
(Approximate distance and direction from nearest city or town)

and is more particularly described as follows:

(a) 25 1/2 feet South and 28 feet East from NE corner D.L.C. 78
(Give distance and bearing to corner of section or other legal subdivision)

being within NW 1/4 NW 1/4 of Sec. 35, Twp. 37 S., Rge. 2 W.
(Smallest legal subdivision) (N. or S.) (E. or W.)

or (b) within limits of recorded platted property, town or city:

in Lot _____, Block _____ of _____
(Name of plat or addition)

County of _____
(If within city or town, give name)

3. Construction Work was begun on April 1940, was completed on April 1940
(Date) (Date)

and the ground water claimed was first used for the purposes set out below on June 1940
(Date)

since which time the water has been used continuously
(Continuously or intermittently)

from 1940 to date
(Date) (Date)

4. Quantity of water claimed and used is 153 gallons per minute; 4.5 acre feet per year.

5. Purpose or Purposes for which water is used irrigation

(Domestic, irrigation, municipal, manufacturing, industrial, etc.)

6. Description of Well: Depth 9.0 feet. Type dig
(Dug or drilled)

diameter 40" x 24" ft. Elevation of ground at well site 1125 feet, mean sea level.
(As near as known)

Depth to water table 4.0 feet. See item 11.

7. Capacity of Well: _____ g.p.m. with _____ feet drawdown.

_____ g.p.m. with _____ feet drawdown.


Date of test _____

If Flowing Well: Measured discharge _____ g.p.m. on _____
(Date)

Shut-in pressure at ground surface _____ lbs. per sq. in. on _____
(Date)

Water is controlled by _____
(Cap, valve, etc.)

Township 37 S Range 2 W, W.M.
North

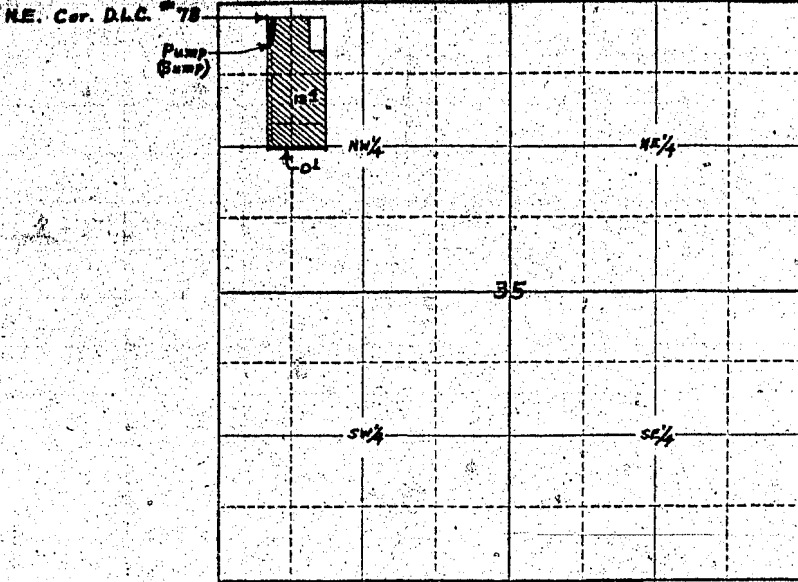

Locate well and acreage of irrigated land on plat.
Scale: $\frac{1}{4}$ " = 1 Mile

STATE OF OREGON

County of Jackson } ss.

I, A. W. Denney, being first duly sworn, do hereby certify that I have read the foregoing Registration Statement and that all of the items therein contained are true to the best of my knowledge and belief.

A. W. Denney
(Signature of Registrant)

Subscribed and sworn to before me this 4 day of February, 1957.

My commission expires Nov. 10, 1957

John R. Drury
(Notary Public)

(SEAL)

CERTIFICATE OF REGISTRATION

STATE OF OREGON

County of Marion } ss.

This is to certify that the foregoing Registration Statement was received in the office of the State Engineer on the 6th day of February, 1957, at 8:00 o'clock A. M. and has been duly recorded in said office in Book No. 2 of Registration Statements on page GR-342 C.

~~Construction shall be completed by the date specified in the order and the water completely applied to beneficial use by the date specified in the order.~~

Witness my hand this 1st day of April, 1957

Lewis A. Stanley
(State Engineer)

By _____ (Deputy)

GR-342 C

\$15.00