

Registration Statement

REGISTRATION NO. GR-3574
CERTIFICATE NO. GR-3283

OF CLAIMANT OF RIGHT TO APPROPRIATE GROUND WATER

(Under Chapter 708, Oregon Laws 1955.)

TO THE STATE ENGINEER OF OREGON:

I, ALEX SMITH

of R.3. Corvallis County of Benton

State of Oregon; do hereby make application for a certificate of registration as evidence of a right to appropriate ground water.

1. Source from which water is withdrawn is Pump well
(Flowing well, pump well, infiltration trench, or tunnel)

2. Location is: 9 miles South of Corvallis
(Approximate distance and direction from nearest city or town)

and is more particularly described as follows:

(a) 196 chs. So. E. 26 chs. E. or w. of NW cor. Dudley Dist. D. & C. #61
(Give distance and bearing to corner of section or other legal subdivision)

being within SW 1/4 NE 1/4 of Sec. 12, Twp. 135, Rge. 5W
(Smallest legal subdivision) (N. or S.) (E. or W.)

or (b) within limits of recorded platted property, town or city:

in Lot _____, Block _____ of _____
(Name of plat or addition)

County of Benton
(If within city or town, give name)

3. Construction Work was begun on _____; was completed on _____
(Date) (Date)

and the ground water claimed was first used for the purposes set out below on _____
(Date)

since which time the water has been used intermittently
(Continuously or intermittently)

from _____ to _____
(Date) (Date)

4. Quantity of water claimed and used is 250 gallons per minute; _____ acre feet per year.

5. Purpose or Purposes for which water is used irrigation
(Domestic, irrigation, municipal, manufacturing, industrial, etc.)

6. Description of Well: Depth 44 feet. Type Drilled
(Dug or drilled)

diameter 6" inches. Elevation of ground at well site 238 feet, mean sea level.
(As near as known)

Depth to water table 10 feet.

7. Capacity of Well: 250 g.p.m. with 12 feet drawdown.

500 g.p.m. with 15 feet drawdown.


Date of test 1-7-39

If Flowing Well: Measured discharge _____ g.p.m. on _____
(Date)

Shut-in pressure at ground surface _____ lbs. per sq. in. on _____
(Date)

Water is controlled by _____
(Cap, valve, etc.)

Township 135 Range SW W.M.
North

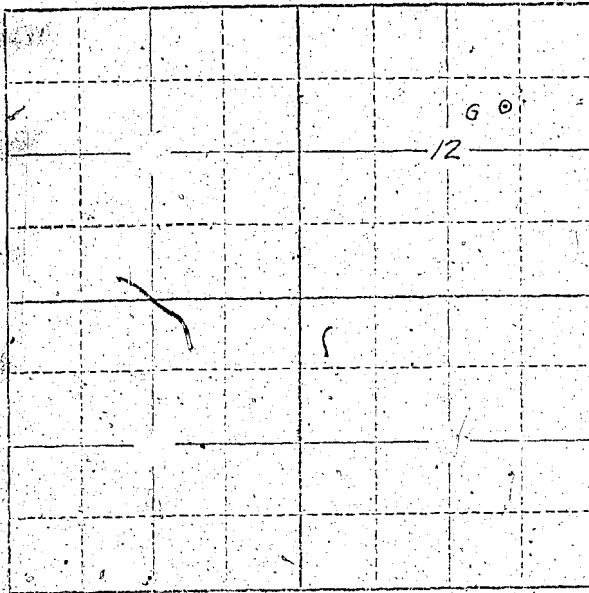

Locate well and acreage of irrigated land on plat.
Scale: 2" = 1 Mile

STATE OF OREGON





My commission expires _____

W. H. G. [unclear]
(Notary Public)

(SEAL)

CERTIFICATE OF REGISTRATION

STATE OF OREGON

County of Marion } ss.




[Signature]
(State Engineer)

By _____ (Deputy)

GR-3283

\$ 21.15