

# Registration Statement

## OF CLAIMANT OF RIGHT TO APPROPRIATE GROUND WATER

TO THE STATE ENGINEER OF OREGON:

I, Alva M Colpitts  
 of R2-Box 148 Springfield County of Lane  
(Mailing address)  
 State of Oregon, do hereby make application for a certificate of registration as evidence  
 of a right to appropriate ground water.

4 Pipes manifolded

1. Source from which water is withdrawn is Pump well #1  
(Flowing well, pump well, infiltration trench, or tunnel)
2. Location is: 9 miles east of Springfield  
(Approximate distance and direction from nearest city or town)

and is more particularly described as follows:

(a) 1450 feet east & 1275 feet north from NW corner  
(Give distance and bearing to corner of section or other legal subdivision)  
 being within SE 1/4 of NW 1/4 of Sec. 32, Twp. 17S, Rge. 1W  
(Smallest legal subdivision) (N. or S.) (E. or W.)  
 or (b) within limits of recorded platted property, town or city:  
 in Lot \_\_\_\_\_, Block \_\_\_\_\_ of \_\_\_\_\_  
(Name of plat or addition)  
 County of \_\_\_\_\_  
(If within city or town, give name)

3. Construction Work was begun on June 1949; was completed on 1949  
(Date) (Date)  
 and the ground water claimed was first used for the purposes set out below on June 1949  
(Date)  
 since which time the water has been used Intermittently  
(Continuously or Intermittently)  
 from June 15, 1949 to Present  
(Date) (Date)

4. Quantity of water claimed and used is 168 gallons per minute; \_\_\_\_\_ acre  
 feet per year.

5. Purpose or Purposes for which water is used Irrigating pasture  
(Domestic, irrigation, municipal, manufacturing, industrial, etc.)


6. Description of Well: Depth 20 feet. Type Drone  
(Dug or drilled)  
 diameter 4-2" Pipes inches. Elevation of ground at well site \_\_\_\_\_ feet, mean sea level.  
(As near as known)  
 Depth to water table 10 feet.

7. Capacity of Well: \_\_\_\_\_ g.p.m. with \_\_\_\_\_ feet drawdown.  
 \_\_\_\_\_ g.p.m. with \_\_\_\_\_ feet drawdown.  
 Date of test \_\_\_\_\_  
 If Flowing Well: Measured discharge \_\_\_\_\_ g.p.m. on \_\_\_\_\_  
(Date)  
 Shut-in pressure at ground surface \_\_\_\_\_ lbs. per sq. in. on \_\_\_\_\_  
(Date)  
 Water is controlled by \_\_\_\_\_  
(Cap. valve, etc.)





Township 175 Range 1W, W.M.  
North

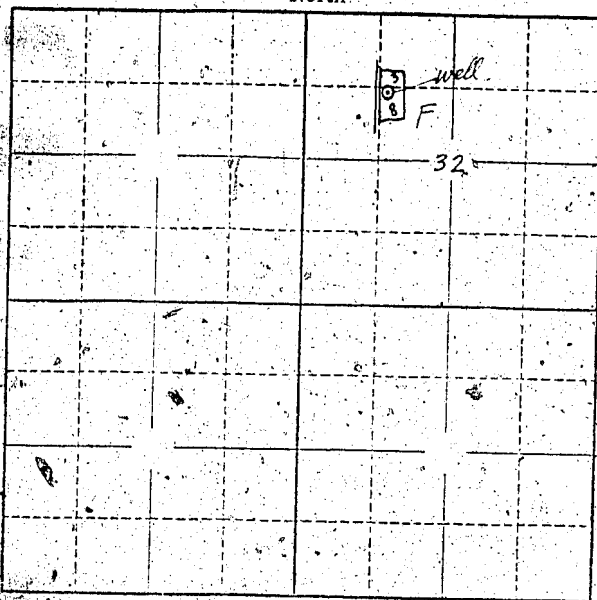

Locate well and acreage of irrigated land on plat.  
Scale: 2" = 1 Mile

STATE OF OREGON

County of Wasco } ss.

I, \_\_\_\_\_, being first duly sworn, do hereby certify that I have read the foregoing Registration Statement and that all of the items therein contained are true to the best of my knowledge and belief.

Rhonda Colette  
(Signature of Registrant)

Subscribed and sworn to before me this 1st day of April, 1958

My commission expires 12th June 1961 W. S. [Signature]  
(Notary Public)

(SEAL)

**CERTIFICATE OF REGISTRATION**

STATE OF OREGON

County of Marion } ss.

This is to certify that the foregoing Registration Statement was received in the office of the State Engineer on the \_\_\_\_\_ day of \_\_\_\_\_, 19\_\_\_\_, at \_\_\_\_\_ o'clock \_\_\_\_\_ M. and has been duly recorded in said office in Book No. 14 of Registration Statements on page GR-3288

Witness my hand this \_\_\_\_\_ day of \_\_\_\_\_, 1958

(State Engineer)

By \_\_\_\_\_ (Deputy)

GR-3288