

Registration Statement

OF CLAIMANT OF RIGHT TO APPROPRIATE GROUND WATER

(Under Chapter 708, Oregon Laws 1955.)

TO THE STATE ENGINEER OF OREGON:

I, T. E. Tryon Route 1, Box 362

of Springfield County of Lane

State of Oregon, do hereby make application for a certificate of registration as evidence of a right to appropriate ground water:

1. Source from which water is withdrawn is Infiltration Trench
(Flowing well, pump well, infiltration trench, or tunnel)

2. Location is: 2 1/2 miles Southeast of Springfield
(Approximate distance and direction from nearest city or town)

and is more particularly described as follows:

(a) 3078.39 North 42° 12' East from the Southwest corner of David L. Arthur T.L.C. #83
(Give distance and bearing to corner of section or other legal subdivision)

being within N.W. 1/4 of the S.E. 1/4 of Sec. 5, Twp. 18 South Rge. 2 West
(Smallest legal subdivision) (N. or S.) (E. or W.)

or (b) within limits of recorded platted property, town or city:

in Lot _____ Block _____ of _____
(Name of plat or addition)

County of _____
(If within city or town, give name)

3. Construction Work was begun on 1948; was completed on 1950
(Date) (Date)

and the ground water claimed was first used for the purposes set out below on 1948
(Date)

since which time the water has been used Int.
(Continuously or Intermittently)

from May to October
(Date) (Date)

4. Quantity of water claimed and used is 1,000 gallons per minute; _____ acre feet per year.

5. Purpose or Purposes for which water is used Irrigation

(Domestic, irrigation, municipal, manufacturing, industrial, etc.)

6. Description of Well: Depth _____ feet. Type _____
(Dug or drilled)

diameter 3 1/2 inches. Elevation of ground at well site _____ feet, mean sea level.
(As near as known)

Depth to water table _____ feet.

7. Capacity of Well: 2000 g.p.m. with _____ feet drawdown.

_____ g.p.m. with _____ feet drawdown.

Date of test 3-17-1950


If Flowing Well: Measured discharge _____ g.p.m. on _____
(Date)

Shut-in pressure at ground surface _____ lbs. per sq. in. on _____
(Date)

Water is controlled by _____
(Cap, valve, etc.)

Township 11th So. Range 2 West W.M.

North

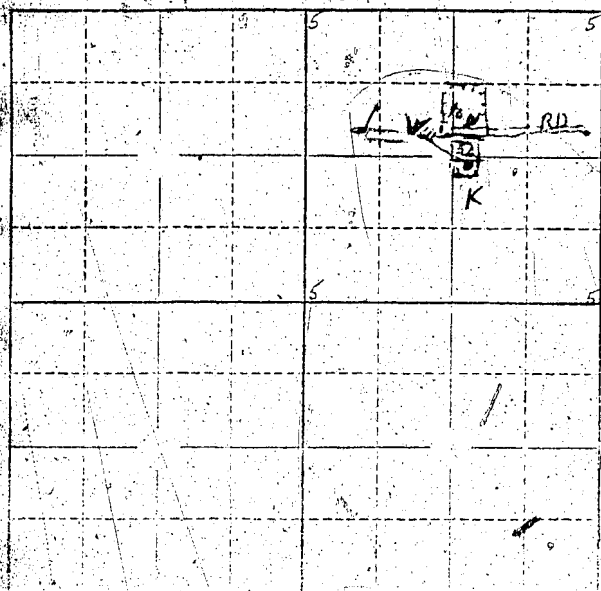

Locate well and acreage of irrigated land on plat.

Scale: 2 1/2 Miles

STATE OF OREGON

County of Lane

I, T. F. Tryon being first duly sworn, do hereby certify that I have read the foregoing Registration Statement and that all of the items therein contained are true to the best of my knowledge and belief.

Thomas F. Tryon
(Signature of Registrar)

Subscribed and sworn to before me this 22nd day of April 19 58

My commission expires

(Notary Public)

(SEAL)

CERTIFICATE OF REGISTRATION

STATE OF OREGON

County of Marion

This is to certify that the foregoing Registration Statement was received in the office of the State Engineer on the _____ day of _____ 19____, at _____ o'clock _____ M. and has been duly recorded in said office in Book No. 14 of Registration Statements on page GR 3280

Construction shall be completed by _____ 19____ and the water completely applied to beneficial use by _____ 19____

Witness my hand this _____ day of _____ 19____

(State Engineer)

By GR-3280

(Deputy)

7/5.00