

Registration Statement

OF CLAIMANT OF RIGHT TO APPROPRIATE GROUND WATER

#2 Well

TO THE STATE ENGINEER OF OREGON:

I, Merton B. Schow
of RT 1 Box 75 Corvallis County of Washington
(Mailing address)

State of Oregon, do hereby make application for a certificate of registration as evidence of a right to appropriate ground water.

1. Source from which water is withdrawn is pump well #2
(Flowing well, pump well, infiltration trench, or tunnel)
2. Location is: 2 miles North of Hillsboro
(Approximate distance and direction from nearest city or town)

and is more particularly described as follows:

(a) S 72° 0' E 1800 feet from NE corner of Section 16
(Give distance and bearing to corner of section or other legal subdivision)
being within SE 1/4 of 1034 of Sec. 16, Twp. 11 N, Rge. 30 W
(Smallest legal subdivision) (N. or S.) (E. or W.)

or (b) within limits of recorded platted property, town or city:
in Lot _____, Block _____ of _____
(Name of plat or addition)

County of Washington
(If within city or town, give name)

3. Construction Work was begun on September 1950; was completed on Sept. 1950
(Date) (Date)

and the ground water claimed was first used for the purposes set out below on Sept. 1950
(Date)

since which time the water has been used Continuously
(Continuously or intermittently)

from September 1950 to March 1951
(Date) (Date)

4. Quantity of water claimed and used is 40 gallons per minute; 67 acre feet per year.

5. Purpose or Purposes for which water is used Domestic - Irrigation
(Domestic, irrigation, municipal, manufacturing, industrial, etc.)

6. Description of Well: Depth 42 feet. Type Drilled
(Dug or drilled)
diameter 8 inches. Elevation of ground at well site _____ feet, mean sea level.
(As near as known)
Depth to water table 10 feet.

7. Capacity of Well: 70 g.p.m. with _____ feet drawdown.
_____ g.p.m. with _____ feet drawdown.


Date of test Sept. 1950

If Flowing Well: Measured discharge _____ g.p.m. on _____
(Date)

Shut-in pressure at ground surface _____ lbs. per sq. in. on _____
(Date)

Water is controlled by _____
(Cap, valve, etc.)

Township 11N Range 3W, W.M.
North

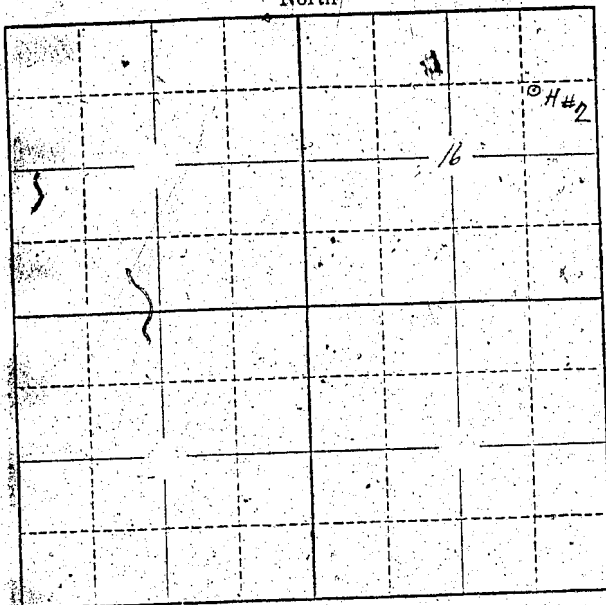

Locate well and acreage of irrigated land on plat.
Scale: 2" = 1 Mile

STATE OF OREGON

County of Marion

ss.

I, _____, being first duly sworn, do hereby certify that I have read the foregoing Registration Statement and that all of the items therein contained are true to the best of my knowledge and belief.

Walter B. Labron
(Signature of Registrant)

Subscribed and sworn to before me this 26th day of March, 1952.

My commission expires 12th June 1961

Wm. S. Bartholomew
(Notary Public)

(SEAL)

CERTIFICATE OF REGISTRATION

STATE OF OREGON

County of Marion

This is to certify that the foregoing Registration Statement was received in the office of the State Engineer on the _____ day of _____, 19____, at _____ o'clock _____ M. and has been duly recorded in said office in Book No. 14 of Registration Statements on page GR-3291

Witness my hand this 20th day of July, 1952

(State Engineer)

By _____ (Deputy)

GR-3291