

Registration Statement

REGISTRATION NO. 3584
CERTIFICATE NO. GR-3293

OF CLAIMANT OF RIGHT TO APPROPRIATE GROUND WATER

(Under Chapter 708, Oregon Laws 1955.)

TO THE STATE ENGINEER OF OREGON:

I, Fred C Crafts

of 1127 Col Young Rd Eugene County of Lane

State of Oregon, do hereby make application for a certificate of registration as evidence of a right to appropriate ground water.

1. Source from which water is withdrawn is pump well
(Flowing well, pump well, infiltration trench, or tunnel)

2. Location is: 3 miles north - Eugene
(Approximate distance and direction from nearest city or town)

and is more particularly described as follows:

(a) 335 ft north then 171 ft west of the northwest corner of the
Charles W Young DLC #53 (Give distance and bearing to corner of section or other legal subdivision)
being within SW 4 of NE of Sec. 18 Twp. 17S Rge. 3W
(Smallest legal subdivision) (S. or S.) (W. or W.)

or (b) within limits of recorded platted property, town or city:

in Lot _____, Block _____ of _____
(Name of plat or addition)

County of _____
(If within city or town, give name)

3. Construction Work was begun on 1941 was completed on before 1941
(Date) (Date)

and the ground water claimed was first used for the purposes set out below on before 1941
(Date)

since which time the water has been used continuously
(Continuously or Intermittently)

from before 1941 to 7-28-58
(Date) (Date)

4. Quantity of water claimed and used is 25 gallons per minute; 1/2 acre feet per year.

5. Purpose or Purposes for which water is used irrigation

(Domestic, irrigation, municipal, manufacturing, industrial, etc.)

6. Description of Well: Depth 40 feet. Type drilled
(Dug or drilled)

diameter 2 inches. Elevation of ground at well site 540 feet mean sea level.
(As near as known)

Depth to water table 12 feet.

7. Capacity of Well: 25 g.p.m. with 3 ft feet drawdown.

g.p.m. with _____ feet drawdown.


Date of test _____

If Flowing Well: Measured discharge _____ g.p.m. on _____
(Date)

Shut-in pressure at ground surface _____ lbs. per sq. in. on _____
(Date)

Water is controlled by _____
(Cap, valve, etc.)

Township 17S Range 3W W.M.
North

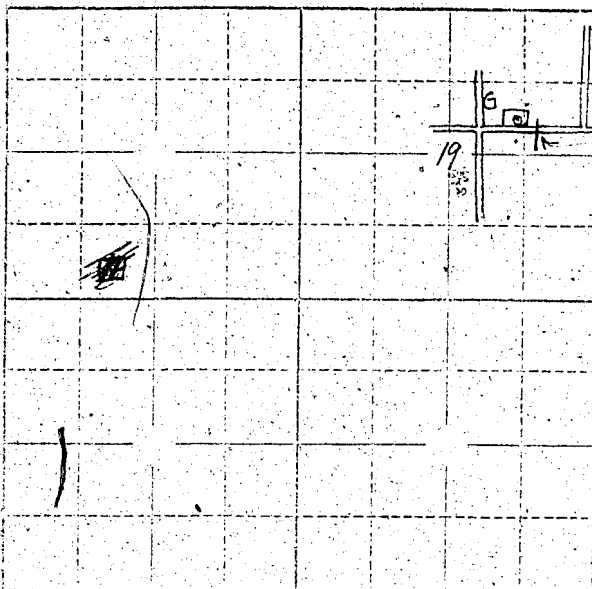

Locate well and acreage of irrigated land on plat.
Scale: 2" = 1 Mile

STATE OF OREGON

County of _____ ss.

I, Fred C. Craft, being first duly sworn, do hereby certify that I have read the foregoing Registration Statement and that all of the items therein contained are true to the best of my knowledge and belief.

Fred C. Craft
(Signature of Registrant)

Subscribed and sworn to before me this _____ day of _____ 19__

My commission expires _____
(Notary Public)

(SEAL)

CERTIFICATE OF REGISTRATION

STATE OF OREGON

County of Marion } ss.

This is to certify that the foregoing Registration Statement was received in the office of the State Engineer on the 14 day of July, 1959, at _____ o'clock _____ M. and has been duly recorded in said office in Book No. 14 of Registration Statements on page GR-3293

~~Construction shall be completed by _____ and the water completely applied to beneficial use by _____~~

Witness my hand this 20th day of July, 1959

(State Engineer)

By _____
(Deputy)

GR-3293