

Registration Statement

OF CLAIMANT OF RIGHT TO APPROPRIATE GROUND WATER

TO THE STATE ENGINEER OF OREGON:

I, R. J. WRIGHT
of Rt. 1, box 353, Springfield
4287 MEKEOR HIGHWAY (Mailing address) County of LANE

State of OREGON, do hereby make application for a certificate of registration as evidence of a right to appropriate ground water.

1. Source from which water is withdrawn is PUMP WELL
(Flowing well, pump well, infiltration trench, or tunnel)

2. Location is: 3 MILES SOUTHWEST OF SPRINGFIELD, OREGON
(Approximate distance and direction from nearest city or town)

and is more particularly described as follows:

(a) 2712 East & 1290 North of the SW Cor. of D.L.C. #63
(Give distance and bearing to corner of section or other legal subdivision)
being within ORIG. LAND CLAIM #63 of Sec. 5, Twp. 18 S, Rge. 2 W
(Smallest legal subdivision) (N. or S.) (E. or W.)

or (b) within limits of recorded platted property, town or city: _____

in Lot _____, Block _____ of _____
(Name of plat or addition)

County of _____
(If within city or town, give name)

3. Construction Work was begun on 1938; was completed on 15 APRIL 1928
(Date) (Date)

and the ground water claimed was first used for the purposes set out below on 15 IN 20 YEARS AGO 1940
(Date)

since which time the water has been used INTERMITTENTLY
(Continuously or intermittently)
from APPROX 1940 to PRESENT TIME
(Date) (Date)

4. Quantity of water claimed and used is 176 gallons per minute; 58 acre feet per year.

5. Purpose or Purposes for which water is used IRRIGATION

(Domestic, irrigation, municipal, manufacturing, industrial, etc.)

6. Description of Well: Depth 25 feet. Type DUG
(Dug or drilled)

diameter 60 inches. Elevation of ground at well site _____ feet, mean sea level.
(As near as known)

Depth to water table 8' feet.

7. Capacity of Well: _____ g.p.m. with _____ feet drawdown.

_____ g.p.m. with _____ feet drawdown.

Date of test _____

If Flowing Well: Measured discharge _____ g.p.m. on _____
(Date)

Shut-in pressure at ground surface _____ lbs. per sq. in. on _____
(Date)

Water is controlled by _____
(Cap, valve, etc.)

8. Casing: (Give diameter, commercial specifications and depth below ground surface of each casing size.)

..... inch diameter from to feet
 inch diameter from to feet
 inch diameter from to feet
 inch diameter from to feet

Describe and show depth of shoe, plug, adapter, liner or other details: *The feed valve of the 4" Suction pipe is 20' below the surface of the ground*

9. Perforated Casings or Screens:

No perforations or screens from to
(Number per foot and size of perforations, or describe screen)
 from to
 from to
 from to

10. Log of Well: (Describe each stratum or formation clearly, indicate if water bearing, and give thickness and depth as indicated.)

MATERIAL	Thickness (Feet)	Depth to Bottom (Feet)
<i>0'-4' - Sandy Loam</i>	<i>4</i>	<i>4</i>
<i>4'-25' - River Gravel</i>	<i>21</i>	<i>25</i>

If log of well is not available, give name and address of driller.

11. Infiltration Trench: Covered or open
 Dimensions: Length ft. Minimum depth ft. Maximum depth ft.
 Bottom width ft. Discharge g.p.m. Date of test

12. Tunnel: Type of lining
 Dimensions:
(Length, course, and cross sectional size)
 Position of water bearing stratum with reference to portal of tunnel

Log of tunnel: (Preceding table for log of well may be used, if desired. Give footage from portal and character of materials, as pertinent.)


13. Pumping Equipment:
 (a) Pump 2 1/2 in. Centrifugal Pump Capacity 200 g.p.m.
(Make, type and size)
 (b) Motor G.E. - 5 H.P. Electric Motor
(Type and horsepower)

14. Location of area irrigated or to be irrigated, or place of use if for purposes other than irrigation.

Township North or South	Range E. or W. of Willamette Meridian	Section	Forty-acre Tract	Number Acres To Be Irrigated	Date of Reclamation
185	2W	5		27 ACRES	
185	2W	5	NW-SE	4	1940
"	"	"	NE-SE	9	"
"	"	"	SE-SE	10	"
"	"	"	SW-SE	5	"
			Total	28	"

15. If the ground water supply is supplemental to an existing water supply, identification of any application for a permit, permit, certificate or adjudicated right to appropriate water made or held by the registrant.

Township 185 Range 2 W, W.M.
North

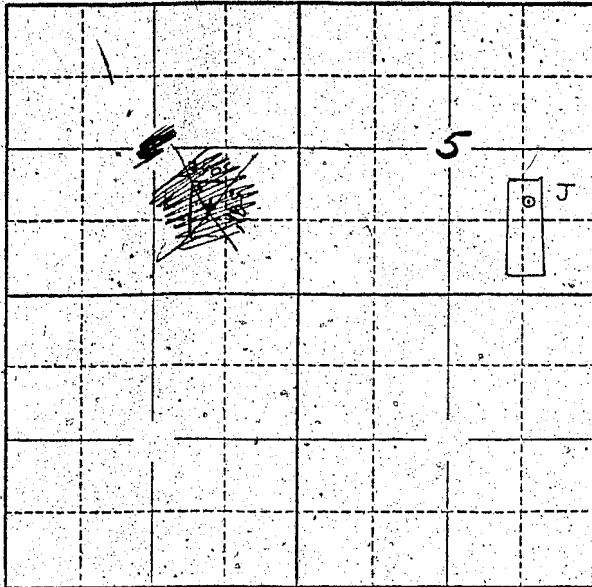

Locate well and acreage of irrigated land on plat.
Scale: 2" = 1 Mile

STATE OF OREGON

County of A T E } ss.

I, R. J. Wright, being first duly sworn, do hereby certify that I have read the foregoing Registration Statement and that all of the items therein contained are true to the best of my knowledge and belief.

R. J. Wright
(Signature of Registrant)

Subscribed and sworn to before me this 21st day of July, 1958.

My commission expires March 15, 1959 Harold Shinn Sr.
(Notary Public)

(SEAL)

CERTIFICATE OF REGISTRATION

STATE OF OREGON

County of Marion } ss.

This is to certify that the foregoing Registration Statement was received in the office of the State Engineer on the 13th day of August, 1958, at 8:00 o'clock A.M. and has been duly recorded in said office in Book No. 16 of Registration Statements on page GR-3977.

Witness my hand this 15th day of February, 1960

Lewis A. Stanley
(State Engineer)

By _____
(Deputy)

\$ 15.00

GR 3977