

# Registration Statement

## OF CLAIMANT OF RIGHT TO APPROPRIATE GROUND WATER

TO THE STATE ENGINEER OF OREGON:

I, Carroll D. Hurd  
of 305 Lower Goodpasture Road County of Lane

State of Oregon, do hereby make application for a certificate of registration as evidence of a right to appropriate ground water.

1. Source from which water is withdrawn is pump well  
(flowing well, pump well, infiltration trench, or tunnel)

2. Location is: 2 mi north & west of Eugene  
(Approximate distance and direction from nearest city or town)

and is more particularly described as follows: 900 feet North of 450 feet east from SW corner Section 19

(a) 50 feet East & north  
Give distance and bearing to corner of section or other legal subdivision

being within lot 18 Richard Garden of Sec. 19, Twp. 17 S, Rge. 3 W  
(Smallest legal subdivision) (or S.) (or W.)

or (b) within limits of recorded platted property, town or city:

in Lot 18, Block \_\_\_\_\_ of Richard Garden  
(Name of plat or addition)

Eugene County of Lane  
(If within city or town, give name)

3. Construction Work was begun on Aug 19 1950, was completed on Aug 10 1950  
(Date) (Date)

and the ground water claimed was first used for the purposes set out below on Aug 19 1950  
(Date)

since which time the water has been used intermittently  
(Continuously or Intermittently)

from Aug 19 1950 to July 31 1958  
(Date) (Date)

4. Quantity of water claimed and used is 56 gallons per minute; \_\_\_\_\_ acre feet per year.

5. Purpose or Purposes for which water is used pasture, Orchard and garden  
(Domestic, irrigation, municipal, manufacturing, industrial, etc.)

6. Description of Well: Depth 20 feet; Type driven  
(Dug or drilled)

diameter 2 inches. Elevation of ground at well site 400 feet mean sea level.  
(As near as known)

Depth to water table 8 feet.

7. Capacity of Well: 130 g.p.m. with unknown feet drawdown.

\_\_\_\_\_ g.p.m. with \_\_\_\_\_ feet drawdown.

Date of test \_\_\_\_\_

If Flowing Well: Measured discharge \_\_\_\_\_ g.p.m. on \_\_\_\_\_ (Date)

Shut-in pressure at ground surface \_\_\_\_\_ lbs. per sq. in. on \_\_\_\_\_ (Date)

Water is controlled by \_\_\_\_\_  
(Cap, valve, etc.)

8. Casing: (Give diameter, commercial specifications and depth below ground surface of each casing size.)

..... inch diameter ..... from ..... to ..... feet  
..... inch diameter ..... from ..... to ..... feet  
..... inch diameter ..... from ..... to ..... feet  
..... inch diameter ..... from ..... to ..... feet

Describe and show depth of shoe, plug, adapter, liner or other details: .....

9. Perforated Casings or Screens:

3.0 inches 4" perforation on pipe ..... from ..... to .....  
(Number per foot and size of perforations/or describe screen)  
..... from ..... to .....  
..... from ..... to .....  
..... from ..... to .....

10. Log of Well: (Describe each stratum or formation clearly, indicate if water bearing, and give thickness and depth as indicated.)

MATERIAL	Thickness (Feet)	Depth to Bottom (Feet)

If log of well is not available, give name and address of driller.

11. **Infiltration Trench:** Covered or open \_\_\_\_\_

Dimensions: Length \_\_\_\_\_ ft. Minimum depth \_\_\_\_\_ ft. Maximum depth \_\_\_\_\_ ft.

Bottom width \_\_\_\_\_ ft. Discharge \_\_\_\_\_ g.p.m. Date of test \_\_\_\_\_

12. **Tunnel:** Type of lining \_\_\_\_\_

Dimensions: \_\_\_\_\_  
(Length, course, and cross sectional size)

Position of water bearing stratum with reference to portal of tunnel \_\_\_\_\_

Log of tunnel: (Preceding table for log of well may be used, if desired. Give footage from portal and character of materials, as pertinent.)

13. **Pumping Equipment:**

(a) Pump Allis-Chalmers Peerless 2 inch Capacity 60 g.p.m.  
(Make, type and size)


(b) Motor Century - 3 H.P. single phase  
(Type and horsepower)

14. Location of area irrigated or to be irrigated, or place of use if for purposes other than irrigation.

Township North or South	Range E. or W. of Willamette Meridian	Section	Forty-acre Tract	Number Acres To Be Irrigated	Date of Reclamation
17	3 W	19	SW 1/4 of SW 1/4	10	Aug 10, 1950

15. If the ground water supply is supplemental to an existing water supply, identification of any application for a permit, permit, certificate or adjudicated right to appropriate water made or held by the registrant.

Township 17S Range 3W W.M.  
North

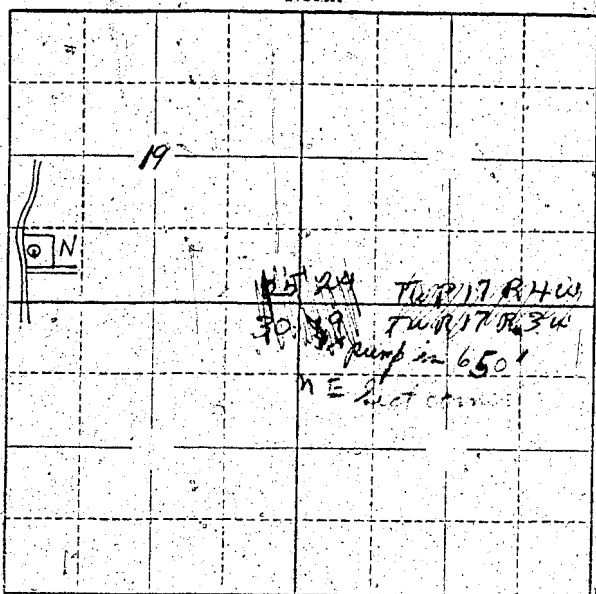

Locate well and acreage of irrigated land on plat.  
Scale: 2" = 1 Mile

STATE OF OREGON

County of Lane

ss.

I, Harris E. Hand, being first duly sworn, do hereby certify that I have read the foregoing Registration Statement and that all of the items therein contained are true to the best of my knowledge and belief.

Harris E. Hand  
(Signature of Registrant)

Subscribed and sworn to before me this 31st day of July, 1955

NOTARY PUBLIC FOR OREGON

My commission expires

My Commission Expires Oct. 16, 1959

(Notary Public)

(SEAL)

CERTIFICATE OF REGISTRATION

STATE OF OREGON

County of Marion

ss.

This is to certify that the foregoing Registration Statement was received in the office of the State Engineer on the \_\_\_\_\_ day of \_\_\_\_\_, 19\_\_\_\_, at \_\_\_\_\_ o'clock \_\_\_\_\_ M. and has been duly recorded in said office in Book No. 14 of Registration Statements on page GR 3291

Witness my hand this 20th day of July, 1955

(State Engineer)

By \_\_\_\_\_ (Deputy)