


Registration Statement

OF CLAIMANT OF RIGHT TO APPROPRIATE GROUND WATER

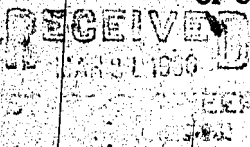

TO THE STATE ENGINEER OF OREGON:

I, Edwin N. Gurdford
of Box 997, Veneta County of Grant
State of Ore, do hereby make application for a certificate of registration as evidence of a right to appropriate ground water.

1. Source from which water is withdrawn is Pumping Well
(Flowing well, pump well, infiltration trench, or tunnel)
2. Location is: In Veneta proper
(Approximate distance and direction from nearest city or town)

and is more particularly described as follows:

(a) 1550 feet South & 960 feet West from N.E. Corner Section 36
(Give distance and bearing to corner of section or other legal subdivision)
being within SE 1/4 of NE 1/4 Lot 3, Block 3 of Sec. 36, Twp. 17 S, Rge. 6 W
(Smallest legal subdivision) (N. or S.) (E. or W.)
or (b) within limits of recorded platted property, town or city: City Town of Veneta
in Lot 3, Block 3 of 1761
(Name of plat or addition)
Veneta County of Grant
(If within city or town, give name)

3. Construction Work was begun on 1940; was completed on 1940
(Date) (Date)
and the ground water claimed was first used for the purposes set out below on 1940
(Date)

since which time the water has been used Intermittently
(Continuously or intermittently)
from 1940 to 1940
(Date) (Date)

4. Quantity of water claimed and used is 8 1/2 gallons per minute; _____ acre feet per year.

5. Purpose or Purposes for which water is used Industrial
(Domestic, irrigation, municipal, manufacturing, industrial, etc.)

6. Description of Well: Depth 95 feet. Type Drilled
(Dug or drilled)
diameter 2 (6") inches. Elevation of ground at well site _____ feet, mean sea level.
(As near as known)
Depth to water table 80 feet.

7. Capacity of Well: _____ g.p.m. with _____ feet drawdown.
_____ g.p.m. with _____ feet drawdown.

Date of test Not tested

If Flowing Well: Measured discharge _____ g.p.m. on _____
(Date)

Shut-in pressure at ground surface _____ lbs. per sq. in. on _____
(Date)

Water is controlled by _____
(Cap, valve, etc.)

8. Casing: (Give diameter, commercial specifications and depth below ground surface of each casing size.)

3 1/2" inch diameter from 0 to 50 feet
..... inch diameter from 7 to feet
..... inch diameter from to feet
..... inch diameter from to feet

Describe and show depth of shoe, plug, adapter, liner or other details:

9. Perforated Casings or Screens:

None from to
(Number per foot and size of perforations, or describe screen)
..... from to
..... from to
..... from to

10. Log of Well: (Describe each stratum or formation clearly, indicate if water bearing, and give thickness and depth as indicated.)

MATERIAL	Thickness (Feet)	Depth to Bottom (Feet)
None		

If log of well is not available, give name and address of driller.

11. Infiltration Trench: Covered or open

Dimensions: Length _____ ft. Minimum depth _____ ft. Maximum depth _____ ft.

Bottom width _____ ft. Discharge _____ g.p.m. Date of test _____

12. Tunnel: Type of lining

Dimensions: _____
(Length, course, and cross sectional size)

Position of water bearing stratum with reference to portal of tunnel _____

Log of tunnel: (Preceding table for log of well may be used, if desired. Give footage from portal and character of materials, as pertinent.)

Pressure 12
Section 2
Delivery 1 1/2

13. Pumping Equipment:

(a) Pump Myers (Ejector) Pump, 8 stage Capacity 5000 g.p.m.
(Make, type and size)

(b) Motor U.S. Motor, 10 Horsepower
(Type and horsepower)


14. Location of area irrigated or to be irrigated, or place of use if for purposes other than irrigation.

Township North or South	Range E. or W. of Willamette Meridian	Section	Forty-acre Tract	Number Acres To Be Irrigated	Date of Reclamation
T17S	R6W	36	SE 1/4 of NE 1/4	Industrial Uses	1940

15. If the ground water supply is supplemental to an existing water supply, identification of any application for a permit, permit, certificate or adjudicated right to appropriate water made or held by the registrant.

Township 17S Range 6W W.M.
North

Quinta
1st add.

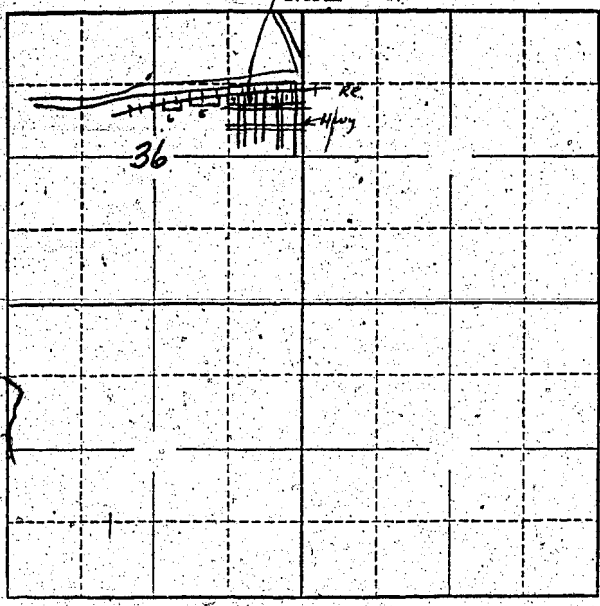

Locate well and acreage of irrigated land on plat.
Scale: 2" = 1.Mile

STATE OF OREGON

County of _____ } ss.

I, _____, being first duly sworn, do hereby certify that I have read the foregoing Registration Statement and that all of the items therein contained are true to the best of my knowledge and belief.

(Signature of Registrant)

Subscribed and sworn to before me this _____ day of _____, 1952

My commission expires _____
(Notary Public)

(SEAL)

CERTIFICATE OF REGISTRATION

STATE OF OREGON

County of Marion } ss.

This is to certify that the foregoing Registration Statement was received in the office of the State Engineer on the 1st day of August, 1952, at 2:00 o'clock A. M. and has been duly recorded in said office in Book No. 16 of Registration Statements on page GR 4037

Witness my hand this 11th day of April, 1960

Louis A. Stanley
(State Engineer)

By _____
(Deputy)

\$ 20.⁰⁰

GR 4037