

# Registration Statement

## OF CLAIMANT OF RIGHT TO APPROPRIATE GROUND WATER

TO THE STATE ENGINEER OF OREGON:

I, RUTH HELEN FLANIGAN

of 1240 Polk Street, Eugene County of Lane  
(Mailing address)

State of Oregon, do hereby make application for a certificate of registration as evidence of a right to appropriate ground water.

1. Source from which water is withdrawn is Pumpwell  
(Flowing well, pump well, infiltration trench, or tunnel)

2. Location is: 3 miles Northwest of Coburg, Oregon  
(Approximate distance and direction from nearest city or town)

and is more particularly described as follows:

(a) 823 feet west and 112 1/2 feet South of NE corner of sec. 24 TP16S R4 WM  
(Give distance and bearing to corner of section or other legal subdivision)  
being within NE 1/4 of NE 1/4 of Sec. 24, Twp. 16 S Rge. 4 W WM  
(Smallest legal subdivision) (N. or S.) (E. or W.)

or (b) within limits of recorded platted property, town or city:

in Lot \_\_\_\_\_, Block \_\_\_\_\_ of \_\_\_\_\_  
(Name of plat or addition)

County of \_\_\_\_\_  
(If within city or town, give name)

3. Construction Work was begun on 1953; was completed on 1953  
(Date) (Date)

and the ground water claimed was first used for the purposes set out below on 1953  
(Date)

since which time the water has been used intermittently  
(Continuously or intermittently)

from May 1 to October 1  
(Date) (Date)

4. Quantity of water claimed and used is 400 gallons per minute; 20 acre feet per year.

5. Purpose or Purposes for which water is used irrigation

(Domestic, irrigation, municipal, manufacturing, industrial, etc.)

6. Description of Well: Depth 30 feet. Type drilled  
(Dug or drilled)

diameter 4 inches. Elevation of ground at well site 390 feet, mean sea level.  
(As near as known)

Depth to water table 5 feet.

7. Capacity of Well: 400 g.p.m. with \_\_\_\_\_ feet drawdown. pumps out \_\_\_\_\_

\_\_\_\_\_ g.p.m. with \_\_\_\_\_ feet drawdown.

Date of test none

If Flowing Well: Measured discharge \_\_\_\_\_ g.p.m. on \_\_\_\_\_  
(Date)


Shut-in pressure at ground surface \_\_\_\_\_ lbs. per sq. in. on \_\_\_\_\_  
(Date)

Water is controlled by \_\_\_\_\_  
(Cap. valve, etc.)





Township 16 S Range 4 W, W.M.  
North

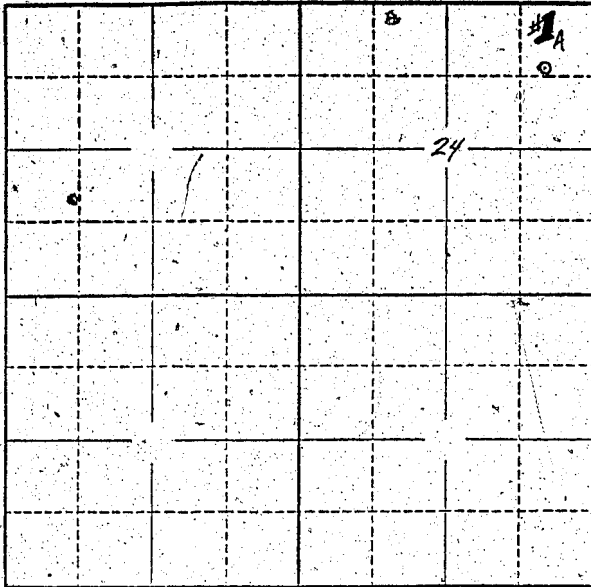

Locate well and acreage of irrigated land on plat.

Scale: 2" = 1 Mile

STATE OF OREGON

County of .....

} ss.

I, ....., being first duly sworn, do hereby certify that I have read the foregoing Registration Statement and that all of the items therein contained are true to the best of my knowledge and belief.

*Ruth Helen Flanagan*  
(Signature of Registrant)

Subscribed and sworn to before me this ..... day of ....., 19.....

My commission expires .....

(Notary Public)

(SEAL)

**CERTIFICATE OF REGISTRATION**

STATE OF OREGON

County of Marion

} ss.

This is to certify that the foregoing Registration Statement was received in the office of the State Engineer on the ..... day of ....., 19.., at ..... o'clock .. M. and has been duly recorded in said office in Book No. 14 of Registration Statements on page GR 3298.

Witness my hand this 20th day of July, 1959.

*Lewis A. Stanley*  
(State Engineer)

By .....

(Deputy)

\$15.00

GR-3298