REGISTRATION NO. GR-9601

CERTIFICATE NO. GR-4104

Registration Statement

OF CLAIMANT OF RIGHT TO APPROPRIATE GROUND WATER

(Under Chapter 708, Oregon Laws 1955.)

TO THE STATE ENGINEER OF OREGON:

I, CHARLES E. YAMADA 8411 S.E. Causey Ave.

of PORTLAND 66 County of CLACKAMAS

State of OREGON, do hereby make application for a certificate of registration as evidence of a right to appropriate ground water.

1. **Source** from which water is withdrawn is Pumped well (Flowing well, pump well, infiltration trench, or tunnel)

2. **Location** is: 8 Miles North of Oregon City (Approximate distance and direction from nearest city or town)

and is more particularly described as follows:

(a) 593.5 N + 605.6 E of W 1/4 Sec. Cor. (Give distance and bearing to corner of section or other legal subdivision)

being within SW1/4 of NW1/4 CAUSEY'S TRACTS 3 & 4 (Smallest legal subdivision) of Sec. 33, Twp. 1 S (N. or S.), Rge. 2 E. (E. or W.)

or (b) within limits of recorded platted property, town or city:

in Lot 3 & 4, Block of CAUSEY'S SUBURBAN TRACT No. 1 (Name of plat or addition)

(If within city or town, give name) County of CLACKAMAS.

3. **Construction Work** was begun on 1927 (Date); was completed on 1927 (Date)

and the ground water claimed was first used for the purposes set out below on 1927 (Date),

since which time the water has been used CONTINUOUS (Continuously or intermittently)

from 1927 (Date) to 1958 (Date)

4. **Quantity** of water claimed and used is 15 gallons per minute; 5 acre feet per year.

5. **Purpose or Purposes** for which water is used IRRIGATION

(Domestic, irrigation, municipal, manufacturing, industrial, etc.)

6. **Description of Well:** Depth 120 feet. Type Drilled (Dug or drilled)

diameter 5 inches. Elevation of ground at well site 50 (As near as known) feet, mean sea level.

Depth to water table 80 feet.

7. **Capacity of Well:** 15 g.p.m. with None feet drawdown.

g.p.m. with feet drawdown.

Date of test NO TEST KNOWN

If Flowing Well: Measured discharge g.p.m. on (Date)

Shut-in pressure at ground surface lbs. per sq. in. on (Date)

Water is controlled by (Cap, valve, etc.)

8. **Casing:** (Give diameter, commercial specifications and depth below ground surface of each casing size.)

5 inch diameter from Surface to 120 feet

..... inch diameter ..... from ..... to ..... feet

..... inch diameter ..... from ..... to ..... feet

..... inch diameter ..... from ..... to ..... feet

Describe and show depth of shoe, plug, adapter, liner or other details: .....

9. **Perforated Casings or Screens:**

..... from ..... to .....
(Number per foot and size of perforations, or describe screen)

..... from ..... to .....

..... from ..... to .....

..... from ..... to .....

10. **Log of Well:** (Describe each stratum or formation clearly, indicate if water bearing, and give thickness and depth as indicated.)

MATERIAL	Thickness (Feet)	Depth to Bottom (Feet)

GR-4104

If log of well is not available, give name and address of driller. Unknown

11. **Infiltration Trench:** Covered or open .....

Dimensions: Length ..... ft. Minimum depth ..... ft. Maximum depth ..... ft.

Bottom width ..... ft. Discharge ..... g.p.m. Date of test .....

12. **Tunnel:** Type of lining .....

Dimensions: ..... (Length, course, and cross sectional size)

Position of water bearing stratum with reference to portal of tunnel .....

Log of tunnel: (Preceding table for log of well may be used, if desired. Give footage from portal and character of materials, as pertinent.)

13. **Pumping Equipment:**

(a) Pump Fairbanks-Morse, - Piston (Make, type and size) Capacity 15 g.p.m.

(b) Motor ..... (Type and horsepower)

14. Location of area irrigated or to be irrigated, or place of use if for purposes other than irrigation.

Township North or South	Range E. or W. of Willamette Meridian	Section	Forty-acre Tract	Number Acres To Be Irrigated	Date of Reclamation
T1S	R2E	33	SW¼ of NW¼ +	5	1927

15. If the ground water supply is supplemental to an existing water supply, identification of any application for a permit, permit, certificate or adjudicated right to appropriate water made or held by the registrant.

Clackamas Water District

GR-4104

33 Township 1S Range 2E, W.M.

North

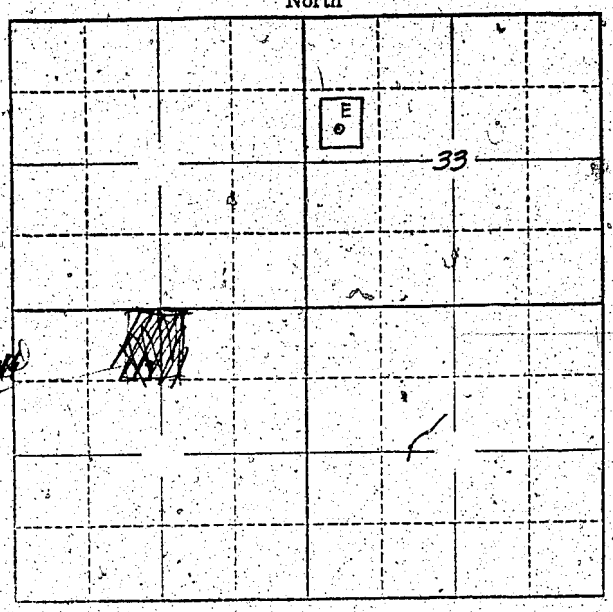

Locate well and acreage of irrigated land on plat.

Scale: 2" = 1 Mile

STATE OF OREGON
County of Clackamas } ss.

I, Charles E. Yamada, being first duly sworn, do hereby certify that I have read the foregoing Registration Statement and that all of the items therein contained are true to the best of my knowledge and belief.

Charles E. Yamada
(Signature of Registrant)

Subscribed and sworn to before me this 7th day of November, 19 60

My commission expires _____

Evelyn Ted Sutton
(Notary Public)

(SEAL)

CERTIFICATE OF REGISTRATION

STATE OF OREGON
County of Marion } ss.

This is to certify that the foregoing Registration Statement was received in the office of the State Engineer on the 15 day of August, 19 52, at 2:00 o'clock P.M. and has been duly recorded in said office in Book No. 17 of Registration Statements on page GR-4104

~~Construction shall be completed by _____ 19 _____ and the water completely applied to beneficial use by _____ 19 _____.~~

Witness my hand this 12th day of December, 19 60.

Lewis A. Stanley
(State Engineer)

$15.00

By _____
(Deputy)

GR-4104