

Registration Statement

OF CLAIMANT OF RIGHT TO APPROPRIATE GROUND WATER

TO THE STATE ENGINEER OF OREGON:

I, Stadium Branch of United States National Bank of Portland
 of 2000 S. W. Morrison County of Multnomah
(Mailing address)
 State of Oregon, do hereby make application for a certificate of registration as evidence
 of a right to appropriate ground water.

1. Source from which water is withdrawn is pump well
(Flowing well, pump well, infiltration trench, or tunnel)
2. Location is: 2000 S. W. Morrison, Portland, Oregon
(Approximate distance and direction from nearest city or town)

and is more particularly described as follows:

(a) 15' S. 65' W. FROM N.E. CORNER OF BLOCK 1, LOT 8
(Give distance and bearing to corner of section or other legal subdivision)
 being within RUSSELL ADDITION of Sec. 33, Twp. 1 N, Rge. 1 E
(Smallest legal subdivision) (N. or S.) (E. or W.)
 or (b) within limits of recorded platted property, town or city: Portland
 in Lot 1, 2, 8, 9, 10, 11 of Russell Addition
(Name of plat or addition)
Portland County of Multnomah
(If within city or town, give name)

3. Construction Work was begun on 5-24-46; was completed on 7-22-46
(Date) (Date)
 and the ground water claimed was first used for the purposes set out below on 1-9-46
(Date)
 since which time the water has been used INTERMITTENTLY
(Continuously or Intermittently)
 from 1-9-46 to DATE
(Date) (Date)

4. Quantity of water claimed and used is 100 gallons per minute; acre feet per year.

5. Purpose or Purposes for which water is used Cooling

(Domestic, irrigation, municipal, manufacturing, industrial, etc.)

6. Description of Well: Depth 563 feet. Type Drilled
(Dug or drilled)
 diameter 7 1/2 inches. Elevation of ground at well site 75 feet, mean sea level.
(As near as known)
 Depth to water table 100 feet.

7. Capacity of Well: 100 g.p.m. with 24 feet drawdown.
 g.p.m. with feet drawdown.

Date of test

If Flowing Well: Measured discharge g.p.m. on (Date)

Shut-in pressure at ground surface lbs. per sq. in. on (Date)

Water is controlled by
(Cap. valve, etc.)

8. Casing: (Give diameter, commercial specifications and depth below ground surface of each casing size.)

6 inch diameter from 0 to 203 feet

6 inch diameter from 184 to 428 feet

inch diameter from to feet

inch diameter from to feet

Describe and show depth of shoe, plug, adapter, liner or other details:

9. Perforated Casings or Screens:

(Number per foot and size of perforations, or describe screen) from to

from to

from to

from to

10. Log of Well: (Describe each stratum or formation clearly, indicate if water bearing, and give thickness and depth as indicated.)

MATERIAL			Thickness (Feet)	Depth to Bottom (Feet)
0'	to	40'	Sand	
40'	"	116'	Loose gravel	
116'	"	128'	Cement gravel	
128'	"	148'	Sand & gravel	
148'	"	177'	Cement gravel	
177'	"	181'	Sand	
181'	"	228'	Cement gravel	
228'	"	300'	Lava rock	
300'	"	317'	Lime rock	
317'	"	354'	Hard black rock	
354'	"	390'	Broken rock with some shale	
390'	"	403'	Lava rock carrying a small amount of water	
403'	"	425'	Black sand	
425'	"	455'	Conglomerate (rock & clay)	
455'	"	480'	Basalt rock	
480'	"	483'	Lava rock	
483'	"	563'	Basalt rock	

If log of well is not available, give name and address of driller.

11. Infiltration Trench: Covered or open

Dimensions: Length ft. Minimum depth ft. Maximum depth ft.

Bottom width ft. Discharge g.p.m. Date of test

12. Tunnel: Type of lining

Dimensions: (Length, course, and cross sectional size)

Position of water bearing stratum with reference to portal of tunnel

Log of tunnel: (Preceding table for log of well may be used, if desired. Give footage from portal and character of materials, as pertinent.)

13. Pumping Equipment:

(a) Pump FAIRBANKS - MORSE Capacity 100 g.p.m.
POMONA TURBINE (Make, type and size)


(b) Motor 15 H.P. 220/440 (Type and horsepower)

14. Location of area irrigated or to be irrigated, or place of use if for purposes other than irrigation.

Township North or South	Range E. or W. of Williams Meridian	Section	Forty-acre Tract	Number Acres To Be Irrigated	Date of Reclamation
T11V	R1E	33	SE 1/4 of S 1/4	Ind.	1946

15. If the ground water supply is supplemental to an existing water supply, identification of any application for a permit, permit, certificate or adjudicated right to appropriate water made or held by the registrant.

Township 1 N Range 1 E, W.M.
North

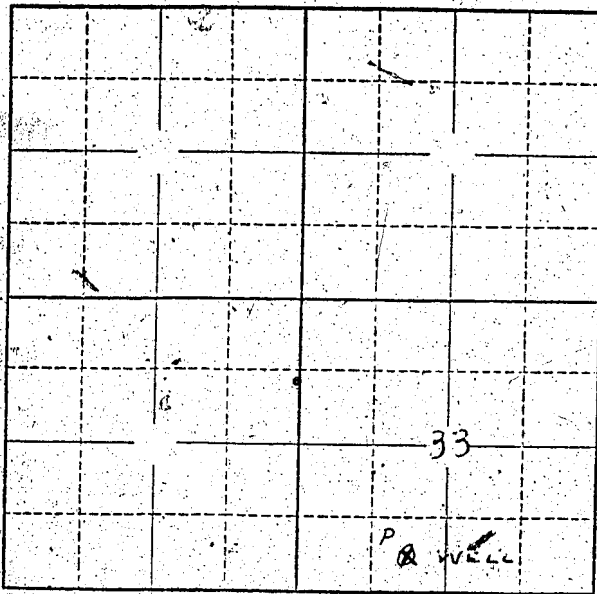

Locate well and acreage of irrigated land on plat.
Scale: 2" = 1 Mile

STATE OF OREGON

County of Multnomah

} ss.

C. I. Meyers, a Trust Officer of The United

I, States National Bank of Portland, being first duly sworn, do hereby certify that I have read the foregoing Registration Statement and that all of the items therein contained are true to the best of my knowledge and belief.

C. I. Meyers

(Signature of Registrant)

Subscribed and sworn to before me this 25th day of July, 1958

My commission expires Jan 2, 1961

C. A. [illegible]

(Notary Public)

(SEAL)

CERTIFICATE OF REGISTRATION

STATE OF OREGON

County of Marion

} ss.

This is to certify that the foregoing Registration Statement was received in the office of the State Engineer on the 1 day of August, 1958, at 11 o'clock A.M. and has been duly recorded in said office in Book No. 13 of Registration Statements on page GR-3155

Witness my hand this 18th day of June, 19 59

Edward A. Stanley

(State Engineer)

By

(Deputy)

\$20.00

GR - 3155