Registration Statement

REGISTRATION NO. GR-361

CERTIFICATE NO. GR 317

OF CLAIMANT OF RIGHT TO APPROPRIATE GROUND WATER

(Under Chapter 708, Oregon Laws 1955.)

TO THE STATE ENGINEER OF OREGON:

I, Earl Brooks Aurora Rt 1 Box 150,

of ..... County of Marion

State of Oregon, do hereby make application for a certificate of registration as evidence of a right to appropriate ground water.

1. **Source** from which water is withdrawn is Pump Well (Flowing well, pump well, infiltration trench, or tunnel)

2. **Location** is: 4 miles west of Woodburn, Oregon (Approximate distance and direction from nearest city or town);

and is more particularly described as follows:

(a). 675 feet west and 1200 feet north from South ¼ corner of section 25. (Give distance and bearing to corner of section or other legal subdivision)

being within SE¼ of SW¼ (Smallest legal subdivision) of Sec. 25, Twp. 4S (N. or S.), Rge. 2W (E. or W.)

or (b) within limits of recorded platted property, town or city: .....

in Lot ....., Block ..... of ..... (Name of plat or addition)

..... (If within city or town, give name) County of .....

3. **Construction Work** was begun on June 1, 1953 (Date); was completed on June 7 1953 (Date)

and the ground water claimed was first used for the purposes set out below on June 1953 (Date);

since which time the water has been used continuously during season (Continuously or intermittently)

from 1953 (Date) to 1956 (Date)

4. **Quantity** of water claimed and used is 70 gallons per minute; ..... acre feet per year.

5. **Purpose or Purposes** for which water is used Irrigation

..... (Domestic, irrigation, municipal, manufacturing, industrial, etc.)

6. **Description of Well:** Depth 120 feet. Type Drilled (Dug or drilled)

diameter 6 inches. Elevation of ground at well site 175 (As near as known) feet, mean sea level.

Depth to water table 15 feet.

7. **Capacity of Well:** ..... g.p.m. with ..... feet drawdown.

..... g.p.m. with ..... feet drawdown.

Date of test .....

If Flowing Well: Measured discharge ..... g.p.m. on ..... (Date)

Shut-in pressure at ground surface ..... lbs. per sq. in. on ..... (Date)

Water is controlled by ..... (Cap, valve, etc.)

8. **Casing:** (Give diameter, commercial specifications and depth below ground surface of each casing size.)

6 inch diameter steel casing from 0 to 120 feet

..... inch diameter ..... from ..... to ..... feet

..... inch diameter ..... from ..... to ..... feet

..... inch diameter ..... from ..... to ..... feet

Describe and show depth of shoe, plug, adapter, liner or other details: .....

9. **Perforated Casings or Screens:**

Mills knife 1 inch slots from 95 to 115
(Number per foot and size of perforations, or describe screen)

gravel packed (9 yards) from 0 to .....

..... from ..... to .....

..... from ..... to .....

10. **Log of Well:** (Describe each stratum or formation clearly, indicate if water bearing, and give thickness and depth as indicated.)

MATERIAL	Thickness (Feet)	Depth to Bottom (Feet)
clay		
Sand (yellow & black)		
clay		

GR 347 A

If log of well is not available, give name and address of driller. Koeneman, E. L.
Hubbard, Oregon

11. **Infiltration Trench:** Covered or open .....

Dimensions: Length ..... ft. Minimum depth ..... ft. Maximum depth ..... ft.

Bottom width ..... ft. Discharge ..... g.p.m. Date of test .....

12. **Tunnel:** Type of lining .....

Dimensions: ..... (length, course, and cross sectional size)

Position of water bearing stratum [illegible] reference to portal of tunnel .....

Log of tunnel: (Preceding table for log of well may be used, if desired. Give footage from portal and character of materials, as pertinent.)

13. **Pumping Equipment:**

(a) Pump Turbine (Make, type and size) Capacity 100 g.p.m.

(b) Motor 5 HP (Type and horsepower)

14. Location of area irrigated or to be irrigated, or place of use if for purposes other than irrigation.

Township North or South	Range E. or W. of Willamette Meridian	Section	Forty-acre Tract	Number Acres To Be Irrigated	Date of Reclamation
4S	2W	25	NE 1/4 of SW 1/4	8	June 1953
	"	25	SE 1/4 of SW 1/4	1	
				9	

15. If the ground water supply is supplemental to an existing water supply, identification of any application for a permit, permit, certificate or adjudicated right to appropriate water made or held by the registrant.

.....

.....

Township 4S Range 2W, W.M.

North

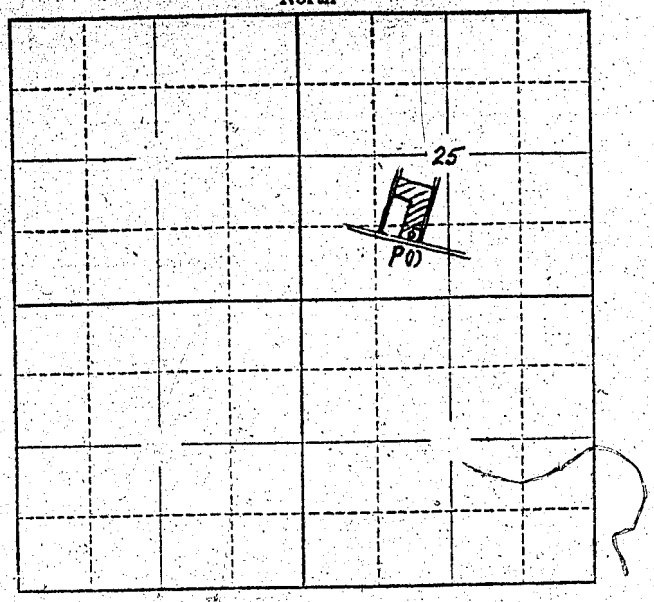

Locate well and acreage of irrigated land on plat.

Scale: 2" = 1 Mile

STATE OF OREGON
County of ..... } ss.

I, Carl Brooks, being first duly sworn, do hereby certify that I have read the foregoing Registration Statement and that all of the items therein contained are true to the best of my knowledge and belief.

Carl Brooks
(Signature of Registrant)

Subscribed and sworn to before me this 7th day of February, 1957

My commission expires Sept. 8, 1960

Chas. A. Walker
(Notary Public)

(SEAL)

CERTIFICATE OF REGISTRATION

STATE OF OREGON
County of Marion } ss.

This is to certify that the foregoing Registration Statement was received in the office of the State Engineer on the 7th day of February, 1957, at 12:00 o'clock A M. and has been duly recorded in said office in Book No. 2 of Registration Statements on page GR-347-C.

~~XXConstruction shall be completed by XXXX