

# Registration Statement

## OF CLAIMANT OF RIGHT TO APPROPRIATE GROUND WATER

TO THE STATE ENGINEER OF OREGON:

I, Lane County School District No. 9

of 1401 Laurel St., Junction City, Oregon County of Junction City

State of Oregon do hereby make application for a certificate of registration as evidence of a right to appropriate ground water.

1. Source from which water is withdrawn is well (Flowing well, pump well, infiltration trench, or tunnel)

2. Location is: Junction City (Approximate distance and direction from nearest city or town)

and is more particularly described as follows: 1382 feet south of 70 feet east from NW corner Section 32.

(a) Laurel School well at corner of 14th Avenue (extended) and Maple Street (extended) (Give distance and bearing to corner of section or other legal subdivision)

being within Sub of NW 1/4 of Sec. 32, Twp. 15S, Rge. 4W (Smallest legal subdivision) (N. or S.) (E. or W.)

or (b) within limits of recorded platted property, town or city: Junction City

in Lot         , Block          of          (Name of plat or addition)

Junction City County of Junction City (If within city or town, give name)

3. Construction Work was begun on 1954; was completed on          (Date) (Date)

and the ground water claimed was first used for the purposes set out below on          (Date)

since which time the water has been used Continuously (Continuously or intermittently)

from          to          (Date) (Date)

4. Quantity of water claimed and used is 10 gallons per minute;          acre feet per year.

5. Purpose or Purposes for which water is used irrigation

(Domestic, irrigation, municipal, manufacturing, industrial, etc.)

6. Description of Well: Depth 29 feet. Type drum (Dug or drilled)

diameter          inches. Elevation of ground at well site          feet mean sea level. (As near as known)

Depth to water table 10 feet.

7. Capacity of Well:          g.p.m. with          feet drawdown.

         g.p.m. with          feet drawdown.

Date of test         

If Flowing Well: Measured discharge          g.p.m. on          (Date)

Shut-in pressure at ground surface          lbs. per sq. in. on          (Date)

Water is controlled by          (Cap, valve, etc.)

8. Casing: (Give diameter, commercial specifications and depth below ground surface of each casing size.)

4 inch diameter ..... from top to 20 feet

inch diameter ..... from ..... to ..... feet

inch diameter ..... from ..... to ..... feet

inch diameter ..... from ..... to ..... feet

Describe and show depth of shoe, plug, adapter, liner or other details: .....

9. Perforated Casings or Screens:

24 Perforation ..... from 24 to 30

(Number per foot and size of perforations, or describe screen)

from ..... to .....

from ..... to .....

from ..... to .....

10. Log of Well: (Describe each stratum or formation clearly, indicate if water bearing, and give thickness and depth as indicated.)

MATERIAL	Thickness (Feet)	Depth to Bottom (Feet)
Brown Loam	12	
Sand gravel	12	10

If log of well is not available, give name and address of driller: .....

11. Infiltration Trench: Covered or open .....

Dimensions: Length ..... ft. Minimum depth ..... ft. Maximum depth ..... ft.

Bottom width ..... ft. Discharge ..... g.p.m. Date of test .....

12. Tunnel: Type of lining .....

Dimensions: .....  
(Length, course, and cross sectional size)

Position of water bearing stratum with reference to portal of tunnel .....

Log of tunnel: (Preceding table for log of well may be used, if desired. Give footage from portal and character of materials, as pertinent.)

13. Pumping Equipment:

(a) Pump *Jacuzzi* *Centrifugal* Capacity *200* g.p.m.  
(Make, type and size)


(b) Motor *Electric* *7 1/2 H.P.*  
(Type and horsepower)

14. Location of area irrigated or to be irrigated, or place of use if for purposes other than irrigation.

Township, North or South	Range E. or W. of Willamette Meridian	Section	Forty-acre Tract	Number Acres To Be Irrigated	Date of Reclamation
T15S	R4W	32	SW 1/4 of NW 1/4	five acres	1954

15. If the ground water supply is supplemental to an existing water supply, identification of any application for a permit, permit, certificate or adjudicated right to appropriate water made or held by the registrant.

Township 15S Range 4W, W.M.  
North

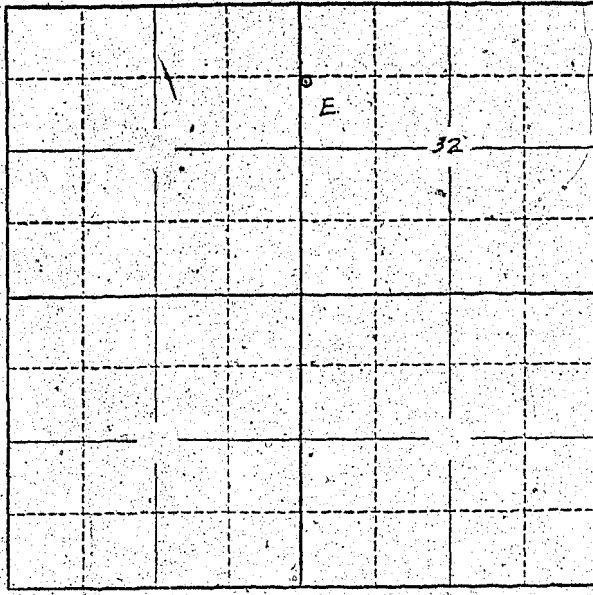

Locate well and acreage of irrigated land on plat.  
Scale: 2" = 1 Mile

STATE OF OREGON

County of Lane } ss.

I, Gertrude Sanders, Clerk of Lane County School District No. 69, being first duly sworn, do hereby certify that I have read the foregoing Registration Statement and that all of the items therein contained are true to the best of my knowledge and belief.

Gertrude Sanders  
(Signature of Registrant)

Subscribed and sworn to before me this 31st day of July, 19 57

My commission expires April 11, 1960

John Stubbart  
(Notary Public)

(SEAL)

**CERTIFICATE OF REGISTRATION**

STATE OF OREGON

County of Marion } ss.

This is to certify that the foregoing Registration Statement was received in the office of the State Engineer on the 1 day of August, 19 58, at 8:00 o'clock A. M. and has been duly recorded in said office in Book No. 16 of Registration Statements on page GR-3992

Witness my hand this 15th day of February, 19 60

Lewis A. Stanley  
(State Engineer)

\$25.00

By \_\_\_\_\_ (Deputy)

GR 3992