

# Registration Statement

## OF CLAIMANT OF RIGHT TO APPROPRIATE GROUND WATER

TO THE STATE ENGINEER OF OREGON:

I, James N. Biornstad RT 3 Box 254  
of Gresham County of Multnomah  
(Mailing address)

State of Oregon, do hereby make application for a certificate of registration as evidence of a right to appropriate ground water.

- 1. Source from which water is withdrawn is Pump well  
(Flowing well, pump well, infiltration trench, or tunnel)
- 2. Location is: 2 1/2 Mi. So. of Gresham  
(Approximate distance and direction from nearest city or town)

and is more particularly described as follows:

(a) S 72° 30' W East 1/4 cor Sec 22  
(Give distance and bearing to corner of section or other legal subdivision)  
being within NE 1/4 SE 1/4 of Sec. 22, Twp. 1 S, Rge. 3 E  
(Smallest legal subdivision) (N. or S.) (E. or W.)

or (b) within limits of recorded platted property, town or city:  
in Lot \_\_\_\_\_, Block \_\_\_\_\_ of \_\_\_\_\_  
(Name of plat or addition)

County of \_\_\_\_\_  
(If within city or town, give name)

3. Construction Work was begun on July 1931; was completed on Sept 1931  
(Date) (Date)  
and the ground water claimed was first used for the purposes set out below on Sept 1931  
(Date)  
since which time the water has been used not continuously 12 mo/yr  
(Continuously or intermittently)  
from 1931 to 1958  
(Date) (Date)

4. Quantity of water claimed and used is 13 gallons per minute; 0 acre feet per year.

5. Purpose or Purposes for which water is used irrigation + greenhouses  
(Domestic, irrigation, municipal, manufacturing, industrial, etc.)

6. Description of Well: Depth 145 feet. Type drilled  
(Dug or drilled)  
diameter 6" inches. Elevation of ground at well site 580 feet, mean sea level.  
(As near as known)  
Depth to water table unknown feet.

7. Capacity of Well: 50 g.p.m. with unknown feet drawdown.  
\_\_\_\_\_ g.p.m. with \_\_\_\_\_ feet drawdown.

Date of test Not tested

If Flowing Well: Measured discharge \_\_\_\_\_ g.p.m. on \_\_\_\_\_  
(Date)


Shut-in pressure at ground surface \_\_\_\_\_ lbs. per sq. in. on \_\_\_\_\_  
(Date)

Water is controlled by \_\_\_\_\_  
(Cap, valve, etc.)





Township 15 Range 3E W.M.  
North

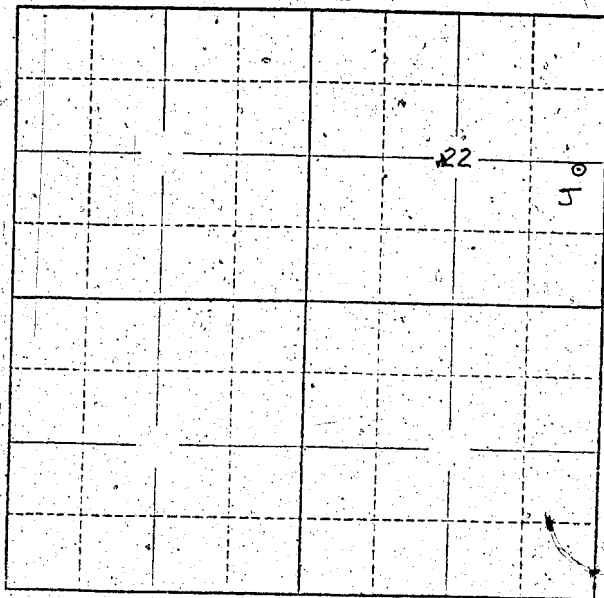

Locate well and acreage of irrigated land on plat.  
Scale: 2" = 1 Mile

STATE OF OREGON

County of Marion } ss.


.....  
(Signature of Registrant)

Subscribed and sworn to before me this ..... day of ..... 19.....

My commission expires .....  
(Notary Public)

(SEAL)

**CERTIFICATE OF REGISTRATION**

STATE OF OREGON

County of Marion } ss.


Witness my hand this ..... day of ..... 19.....

.....  
(State Engineer)

By .....  
(Deputy)


\$1500