

Registration Statement

OF CLAIMANT OF RIGHT TO APPROPRIATE GROUND WATER

TO THE STATE ENGINEER OF OREGON:

I, Gallin & Myrtle J. Beaver
of Route 1, Box 63 Salem County of Dalb
(Mailing address)
State of Oregon, do hereby make application for a certificate of registration as evidence
of a right to appropriate ground water.

1. Source from which water is withdrawn is pump well
(Flowing well, pump well, infiltration trench, or tunnel)
2. Location is: 2 1/4 miles west of Salem
(Approximate distance and direction from nearest city or town)

and is more particularly described as follows:-

- (a) N 3° E 240' & 65° W from the NE Corner of Blk 2 of Burley Fruit Farms.
(Observed and bearing to corner of section or other legal subdivision)
being within SW 1/4 NE 1/4 of Sec. 20, Twp. 7.8, Rge. 32.21M
(Smallest legal subdivision) (S. or S.) (E. or W.)
or (b) within limits of recorded platted property, town or city:
in Lot 8, Block 2 of Burley Fruit Farms
(Name of plat or addition)
County of Dalb
(If within city or town, give name)

3. Construction Work was begun on May 1954; was completed on July 4, 1954
(Date) (Date)
and the ground water claimed was first used for the purposes set out below on July 4, 1954
(Date)
since which time the water has been used continuously in summer
(Continuously or intermittently)
from July 4, 1954 to July 28, 1958
(Date) (Date)
4. Quantity of water claimed and used is 8 gallons per minute; 8 acre
feet per year.

5. Purpose or Purposes for which water is used

irrigation
(Domestic, irrigation, municipal, manufacturing, industrial, etc.)

6. Description of Well: Depth 57 7/8 feet. Type drilled
(Dug or drilled)
diameter 6-8 inches. Elevation of ground at well site 250' feet, mean sea level.
(As near as known)
Depth to water table 33' feet.
(If gpm)

7. Capacity of Well: 720 g.p.m. with 35 feet drawdown.
g.p.m. with feet drawdown.

Date of test

If Flowing Well: Measured discharge g.p.m. on (Date)

Shut-in pressure at ground surface lbs. per sq. in. on (Date)

Water is controlled by (Cap, valve, etc.)

size.)

6 inch diameter from Top to 60 feet

Describe and show depth of shoe, plug, adapter, liner or other details:

9. Perforated Casings or Screens:

(Number per foot and size of perforations, or describe screen)

longitudinal from 40 to 60

10. **Log of Well:** (Describe each stratum or formation clearly, indicate if water bearing, and give thickness and depth/as indicated.)


MATERIAL	Thickness (Feet)	Depth to Bottom (Feet)
Clay to about 33 feet, clay then Alluvial material in which water was found, then soft rock to 60 feet, then hard basalt		70-

GR. 3313

#3, box 177A, S. Iverton, Ore.

[illegible]

Township 7S Range 3W W.M.
North

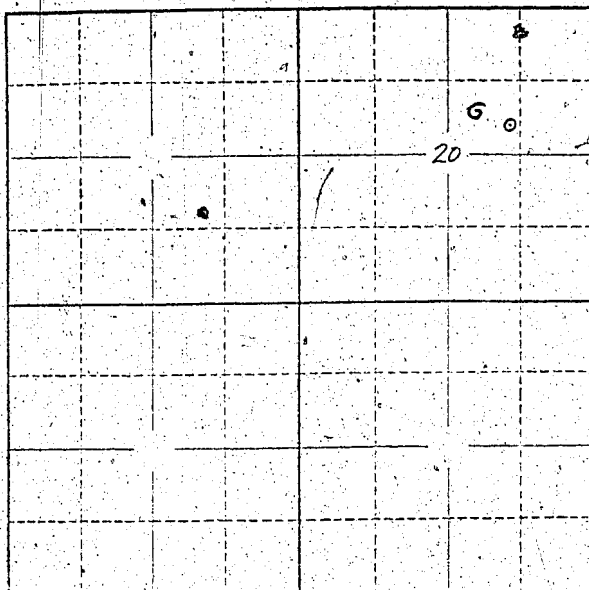

Locate well and acreage of irrigated land on plat.
Scale: 2" = 1 Mile

STATE OF OREGON

County of Marion

ss.

I, Roll Beaver Myrtle Beaver being first duly sworn, do hereby certify that I have read the foregoing Registration Statement and that all of the items therein contained are true to the best of my knowledge and belief.

Roll Beaver Myrtle Beaver
(Signature of Registrant)

Subscribed and sworn to before me this 1st day of August, 1958

My commission expires 12th June 1961

Wm. O. Bartholmeus
(Notary Public)

(SEAL)

CERTIFICATE OF REGISTRATION

STATE OF OREGON

County of Marion

ss.

This is to certify that the foregoing Registration Statement was received in the office of the State Engineer on the 1st day of August, 1958, at 3:20 o'clock P.M. and has been duly recorded in said office in Book No. 14 of Registration Statements on page GR-3313

Witness my hand this 20th day of July, 1959

(State Engineer)

(Deputy)

GR - 3313