

Registration Statement

OF CLAIMANT OF RIGHT TO APPROPRIATE GROUND WATER

TO THE STATE ENGINEER OF OREGON:

I, LEONARD N. HAYS

of 5690 Guinaby Road Salem County of Marion
(Mailing address)

State of Oregon, do hereby make application for a certificate of registration as evidence of a right to appropriate ground water.

1. Source from which water is withdrawn is Pump Well
(Flowing well, pump well, infiltration trench, or tunnel)

2. Location is: 1/2 Miles North of Salem
(Approximate distance and direction from nearest city or town)

and is more particularly described as follows:

(a) 31.84 chains S. 10° 51' W. from the quarter corner on the N.
(Give distance and bearing to corner of section or other legal subdivision)
being within line of Sec. 36--SE $\frac{1}{4}$ of NW $\frac{1}{4}$ of Sec. 36 Twp. 6 S. Rge. 3 W.M.
(Smallest legal subdivision) (N. or S.) (E. or W.)

or (b) within limits of recorded platted property, town or city:

in Lot _____, Block _____ of _____
(Name of plat or addition)
County of Marion
(If within city or town, give name)

3. Construction Work was begun on November 47; was completed on same.
(Date) (Date)

and the ground water claimed was first used for the purposes set out below on 1948
(Date)

since which time the water has been used intermittently as crop needs water
(Continuously or intermittently)
from 1948 to present.
(Date) (Date)

4. Quantity of water claimed and used is 42 gallons per minute; _____ acre
feet per year.

5. Purpose or Purposes for which water is used domestic use and to irrigate acre
(Domestic, irrigation, municipal, manufacturing, industrial, etc.)

6. Description of Well: Depth 44 feet. Type drilled
(Dug or drilled)
diameter 6 inches. Elevation of ground at well site not known feet, mean sea level.
(As near as known)
Depth to water table 16 feet.

7. Capacity of Well: 36 g.p.m. with 23 feet drawdown.
_____ g.p.m. with _____ feet drawdown.


Date of test July 1956

If Flowing Well: Measured discharge _____ g.p.m. on _____
(Date)

Shut-in pressure at ground surface _____ lbs. per sq. in. on _____
(Date)

Water is controlled by _____
(Cap, valve, etc.)

Township 65 Range 3W, W.M.
North

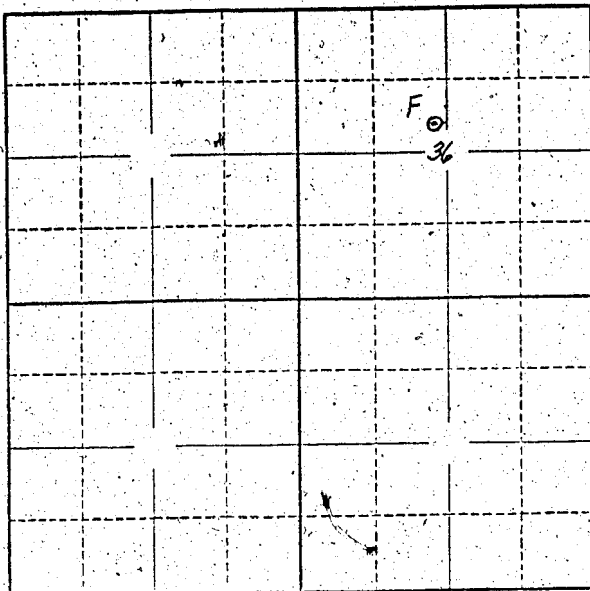

Locate well and acreage of irrigated land on plat.
Scale: 2" = 1 Mile

STATE OF OREGON

County of Marion

} ss.

I, Leonard W. Nays, being first duly sworn, do hereby certify that I have read the foregoing Registration Statement and that all of the items therein contained are true to the best of my knowledge and belief.

Leonard W. Nays

(Signature of Registrant)

Subscribed and sworn to before me this 31 day of July, 1958

My commission expires 26, 1961

David H. Bates

(Notary Public)

(SEAL)

CERTIFICATE OF REGISTRATION

STATE OF OREGON

County of Marion

} ss.

This is to certify that the foregoing Registration Statement was received in the office of the State Engineer on the 1st day of August, 1958, at 10:45 o'clock A. M. and has been duly recorded in said office in Book No. 14 of Registration Statements on page GR- 3356

Witness my hand this 20th day of August, 1959

Lewis A. Stansbury

(State Engineer)

By _____

(Deputy)

#1502

GR 3356