RECEIVED
FEB 7 1957
STATE ENGINEER
SALEM, OREGON

REGISTRATION NO. GR-362

Registration Statement CERTIFICATE NO. GR 348

OF CLAIMANT OF RIGHT TO APPROPRIATE GROUND WATER

(Under Chapter 708, Oregon Laws 1955.)

TO THE STATE ENGINEER OF OREGON:

I, George Genichi Kogiso and Kome Kogiso, husband and wife,

of Rt I Box 29 Sherwood, County of Washington

State of Oregon, do hereby make application for a certificate of registration as evidence of a right to appropriate ground water.

1. **Source** from which water is withdrawn is Pump well
(Flowing well, pump well, infiltration trench, or tunnel)

2. **Location** is: One mile west of Tualatin Oregon
(Approximate distance and direction from nearest city or town)

and is more particularly described as follows:

(a) Aprox 100 feet E of the West line of Sec 23 T 2S R1W and aprox 75' N of the N Line of the Tualatin Sherwood Road C/L 492
(Give distances and bearings to corner of section or other legal subdivision)
being within (Smallest legal subdivision) of Sec. 23, Twp. 2S (N. or S.), Rge. 1W (E. or W.)

or (b) within limits of recorded platted property, town or city:

in Lot ....., Block ..... of ..... (Name of plat or addition)

..... (If within city or town, give name) County of .....

3. **Construction Work** was begun on 1927 or 1928 (Date); was completed on 30 days after start (Date)

and the ground water claimed was first used for the purposes set out below on on completion (Date),

since which time the water has been used continuously as needed (Continuously or intermittently)

from 1927-8 (Date) to present 2/I/57 (Date)

4. **Quantity** of water claimed and used is max of 20,000 gallons per ~~minute~~ ~~130 gpm~~ day; ..... acre feet per year.

5. **Purpose or Purposes** for which water is used Irrigation of Truck Farm
(Domestic, irrigation, municipal, manufacturing, industrial, etc.)

6. **Description of Well:** Depth 125 feet. Type drilled (Dug or drilled)

diameter 6 inches. Elevation of ground at well site ~~200~~ 160 feet (As near as known) feet, mean sea level.

Depth to water table 1 foot feet.

7. **Capacity of Well:** 17 g.p.m. with 60 feet drawdown.

..... g.p.m. with ..... feet drawdown.

Date of test on completion of well--County agent made in 1955

If Flowing Well: Measured discharge ..... g.p.m. on ..... (Date)

Shut-in pressure at ground surface ..... lbs. per sq. in. on ..... (Date)

Water is controlled by ..... (Cap, valve, etc.)

8. **Casing:** (Give diameter, commercial specifications and depth below ground surface of each casing size.)

6 inch diameter ..... from top to 65 feet

No caving beyond rock formation inch diameter ..... from 65 to 125 feet

..... inch diameter ..... from ..... to ..... feet

..... inch diameter ..... from ..... to ..... feet

Describe and show depth of shoe, plug, adapter, liner or other details: .....

9. **Perforated Casings or Screens:**

..... from ..... to .....
(Number per foot and size of perforations, or describe screen)

..... from ..... to .....

..... from ..... to .....

..... from ..... to .....

10. **Log of Well:** (Describe each stratum or formation clearly, indicate if water bearing, and give thickness and depth as indicated.)

MATERIAL	Thickness (Feet)	Depth to Bottom (Feet)
To best of knowledge a mixture of Clay and sand to 65 feet then solid rock		

GR 348 A

If log of well is not available, give name and address of driller. A Mr Olson from Gresham do not know if still in business

11. **Infiltration Trench:** Covered or open _____

Dimensions: Length _____ ft. Minimum depth _____ ft. Maximum depth _____ ft.

Bottom width _____ ft. Discharge _____ g.p.m. Date of test _____

12. **Tunnel:** Type of lining _____

Dimensions: _____
(Length, course, and cross sectional size)

Position of water bearing stratum with reference to portal of tunnel _____

Log of tunnel: (Preceding table for log of well may be used, if desired. Give footage from portal and character of materials, as pertinent.)

13. **Pumping Equipment:**

(a) Pump Jacuzzi (Make, type and size) Capacity 42 g.p.m.

(b) Motor # # 3HP single phase Gen Electric. (Type and horsepower)

14. Location of area irrigated or to be irrigated, or place of use if for purposes other than irrigation.

Township North or South	Range E. or W. of Willamette Meridian	Section	Forty-acre Tract	Number Acres To Be Irrigated	Date of Reclamation
2 S	I W	23	~~W½SW¼~~	15 Total Ac.	1928 was
"	"	"	NW¼ of NW¼	4	"
"	"	"	SW¼ of NW¼	4	"
"	"	"	NW¼ of SW¼	5	"
"	"	"	SW¼ of SW¼	2	"
				15	

15. If the ground water supply is supplemental to an existing water supply, identification of any application for a permit, permit, certificate or adjudicated right to appropriate water made or held by the registrant.

GR 318 B

Township 2S Range 1W, W.M.

North

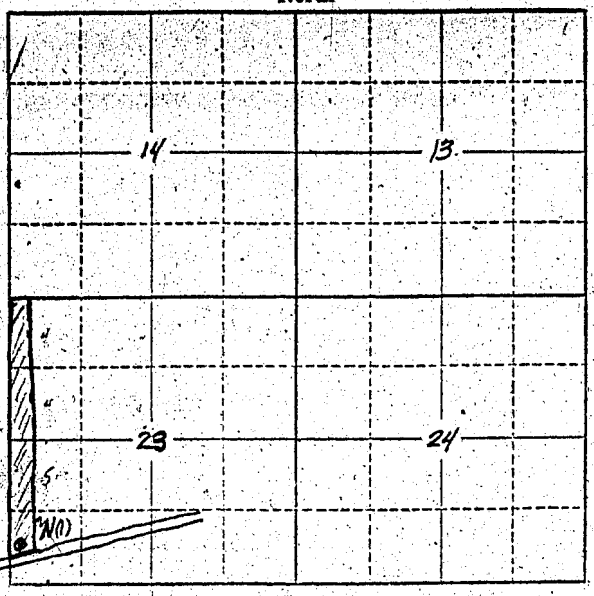

Tualatin
Sherwood Hwy CR#492

Locate well and acreage of irrigated land on plat.

Scale: 2" = 1 Mile

STATE OF OREGON
County of Washington } ss.

I, George G. Kogsa, being first duly sworn, do hereby certify that I have read the foregoing Registration Statement and that all of the items therein contained are true to the best of my knowledge and belief.

x George G Kogsa
(Signature of Registrant)

Subscribed and sworn to before me this 1st day of Feb, 1957

My commission expires Feb 7, 1960 Lucia Anderson
(Notary Public)

(SEAL)

CERTIFICATE OF REGISTRATION

STATE OF OREGON
County of Marion } ss.

This is to certify that the foregoing Registration Statement was received in the office of the State Engineer on the 7th day of February, 19 57, at 8:00 o'clock A. M. and has been duly recorded in said office in Book No. 2 of Registration Statements on page GR-348 C

~~Construction shall be completed by x-x-x-