

Registration Statement

OF CLAIMANT OF RIGHT TO APPROPRIATE GROUND WATER

TO THE STATE ENGINEER OF OREGON:

I, Burt Burton Heb'n Burton

of Rt 2 Box 103 Woodburn, Ore. County of Clackamas

State of Oregon, do hereby make application for a certificate of registration as evidence of a right to appropriate ground water.

1. Source from which water is withdrawn is PUMP WELL
(Flowing well, pump well, infiltration trench, or tunnel)

2. Location is: 2 M. South of Monitor
(Approximate distance and direction from nearest city or town)

and is more particularly described as follows:

(a) 339.6' WEST + 257' for South of NW Cor TJ Chase DLC
(Give distance and bearing to corner of section or other legal subdivision) Orchard Co Tract PL

being within NE 1/4 of NW 1/4 of Sec. 24 Twp. 5S Rge. 1W
(Smallest legal subdivision) (N. or S.) (E. or W.)

or ^{1, 2, 3} within limits of recorded platted property, town or city: WOODBURN ORCHARD CO TRACT

in Lot 14, 19 Block of
(Name of plat or addition)

County of CLACKAMAS
(If within city or town, give name)

3. Construction Work was begun on May 1945; was completed on May 1945
(Date) (Date)

and the ground water claimed was first used for the purposes set out below on May 1945
(Date)

since which time the water has been used Continuously
(Continuously or Intermittently)

from May 1945 to PRESENT
(Date) (Date)

4. Quantity of water claimed and used is 84 gallons per minute; acre feet per year.

5. Purpose or Purposes for which water is used IRRIGATION

(Domestic, irrigation, municipal, manufacturing, industrial, etc.)

6. Description of Well: Depth 92' feet. Type DRILLED
(Dug or drilled)

diameter 6 inches. Elevation of ground at well site 200' feet, mean sea level.
(As near as known)

Depth to water table 20' feet.

7. Capacity of Well: 125 g.p.m. with 50 feet drawdown.

 g.p.m. with feet drawdown.


Date of test May 1945

If Flowing Well: Measured discharge g.p.m. on
(Date)

Shut-in pressure at ground surface lbs. per sq. in. on
(Date)

Water is controlled by
(Cap, valve, etc.)

Township 5S Range 1W W.M.
North

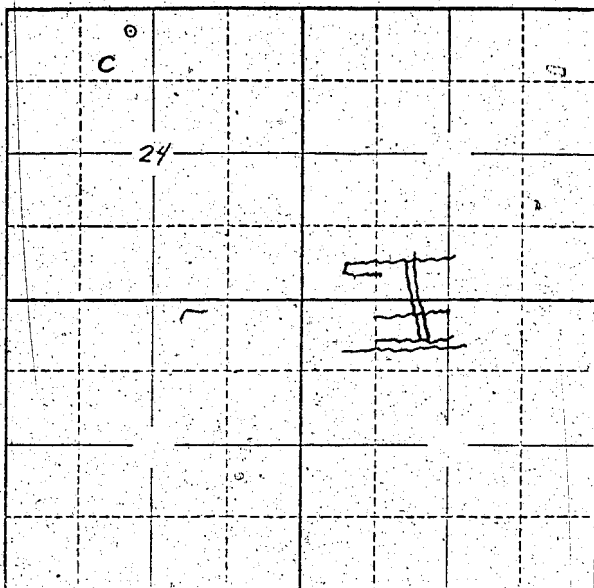

Locate well and acreage of irrigated land on plat.

Scale: 2" = 1 Mile

STATE OF OREGON

County of Marion } ss.

I, Helyn Burton, being first duly sworn, do hereby certify that I have read the foregoing Registration Statement and that all of the items therein contained are true to the best of my knowledge and belief.

Helyn Burton Helyn Burton
(Signature of Registrant)

Subscribed and sworn to before me this 1st day of August, 1958

My commission expires 12th June 1961

Wm. S. Bartholomew
(Notary Public)

(SEAL)

CERTIFICATE OF REGISTRATION

STATE OF OREGON

County of Marion } ss.

This is to certify that the foregoing Registration Statement was received in the office of the State Engineer on the 1st day of August, 1958, at 11:30 o'clock A. M. and has been duly recorded in said office in Book No. 14 of Registration Statements on page GR 3322.

Witness my hand this 20th day of July, 1959

\$15.60

Paul A. Stanley
(State Engineer)

By _____ (Deputy)

GR 3322