

Registration No. GR 3629

Certificate No. GR 3323

Registration Statement

OF CLAIMANT OF RIGHT TO APPROPRIATE GROUND WATER

TO THE STATE ENGINEER OF OREGON:

I, Earl C. Jones

of Rt. 4 Box 2100 Eugene, Oregon County of Lane

State of Oregon, do hereby make application for a certificate of registration as evidence of a right to appropriate ground water.

1. Source from which water is withdrawn is flowing well with pump #1
(Flowing well, pump well, infiltration trench, or tunnel)

2. Location is: 1 and 8 tenths mile southwest of Goshen on Hampton Rd.
(Approximate distance and direction from nearest city or town)

and is more particularly described as follows: 500 feet South & 968 feet east from NW corner Section 26.
Property begins - at a point in the center of the county road 943.9 feet north 89° 49' east from the NW corner of the Silas Brown Donation Land Claim #8.
(Give distance and bearing to corner of section or other legal subdivision)

being within NW 1/4 of NW 1/4 of Sec. 26, Twp. 18 S, Rge. 3 W
(Smallest legal subdivision) (N. or S.) (E. or W.)

or (b) within limits of recorded platted property, town or city:

in Lot _____, Block _____ of _____
(Name of plat or addition)

County of Lane
(If within city or town, give name)

3. Construction Work was begun on June 22, 1954; was completed on June 24, 1954
(Date) (Date)

and the ground water claimed was first used for the purposes set out below on June 25, 1954
(Date)

since which time the water has been used continuously
(Continuously or intermittently)

from June 25, 1954 to August 1, 1958
(Date) (Date)

4. Quantity of water claimed and used is 35 gallons per minute; 7 acre feet per year.

5. Purpose or Purposes for which water is used irrigation

(Domestic, irrigation, municipal, manufacturing, industrial, etc.)

6. Description of Well: Depth 65 feet. Type drilled
(Dug or drilled)

diameter 6 inches. Elevation of ground at well site 480 feet, mean sea level.
(As near as known)

Depth to water table 0 feet.

7. Capacity of Well: 40 g.p.m. with 25 feet drawdown.
_____ g.p.m. with _____ feet drawdown.

Date of test June 24, 1954

If Flowing Well: Measured discharge 1 1/2 g.p.m. on June 24, 1954
(Date)

Shut-in pressure at ground surface not known lbs. per sq. in. on _____
(Date)

Water is controlled by none
(Cap., valve, etc.)

8. Casing: (Give diameter, commercial specifications and depth below ground surface of each casing size.)

6 inch diameter std. galv. iron from 0 to 15 feet
 6 inch diameter std. black iron "coated" from 15 to 40 feet
 inch diameter from to feet
 inch diameter from to feet

Describe and show depth of shoe, plug, adapter, liner or other details: none

9. Perforated Casings or Screens:

4 per. ft. 1 eighth in. by 12 in. from 30 to 40 ft.
(Number per foot and size of perforations, or describe screen)
 from to
 from to
 from to

10. Log of Well: (Describe each stratum or formation clearly, indicate if water bearing, and give thickness and depth as indicated.)

MATERIAL	Thickness (Feet)	Depth to Bottom (Feet)
top soil	2	
clay	26	28
shale type rock - water bearing, to 65 ft.	none	

If log of well is not available, give name and address of driller. myself

11. Infiltration Trench: Covered or open

Dimensions: Length _____ ft. Minimum depth _____ ft. Maximum depth _____ ft.

Bottom width _____ ft. Discharge _____ g.p.m. Date of test _____

12. Tunnel: Type of lining

Dimensions: _____
(Length, course, and cross sectional size)

Position of water bearing stratum with reference to portal of tunnel _____

Log of tunnel: (Preceding table for log of well may be used, if desired. Give footage from portal and character of materials, as pertinent.)

13. Pumping Equipment:

(a) Pump Universal, Jet, 1/2 hp. Capacity 32 g.p.m.
(Make, type and size)


(b) Motor single phase 1/2 hp.
(Type and horsepower)

14. Location of area irrigated or to be irrigated, or place of use if for purposes other than irrigation.

Township North or South	Range E. or W. of Willamette Meridian	Section	Forty-acre Tract	Number Acres To Be Irrigated	Date of Reclamation
<u>18 s</u>	<u>3 w</u>	<u>26</u>	<u>NW 1/4 of NW 1/4</u>	<u>7.2</u>	<u>1954</u>

15. If the ground water supply is supplemental to an existing water supply, identification of any application for a permit, permit, certificate or adjudicated right to appropriate water made or held by the registrant.

Township 18s Range 3w, W.M.
North

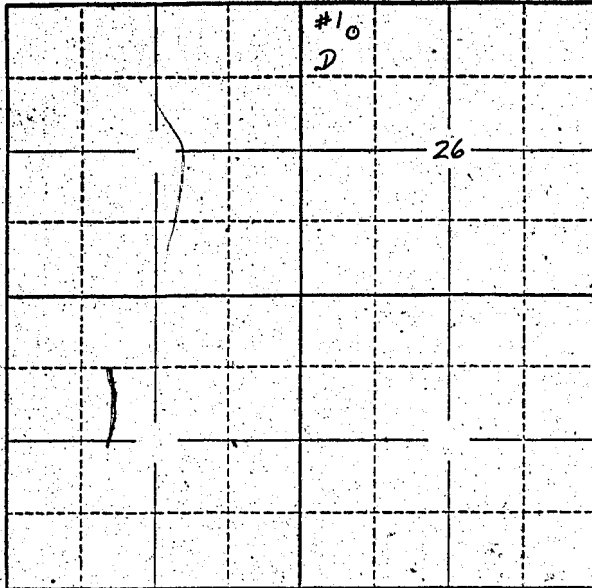

Locate well and acreage of irrigated land on plat.
Scale: 2" = 1 Mile

STATE OF OREGON

County of Lane } ss.

I, Notary Public, being first duly sworn, do hereby certify that I have read the foregoing Registration Statement and that all of the items therein contained are true to the best of my knowledge and belief.

Earl C. Baker
(Signature of Registrant)

Subscribed and sworn to before me this 1st day of August, 1958

MY COMMISSION EXPIRES FEB, 28, 1961

My commission expires Gene E. Bacon
(Notary Public)

(SEAL)

CERTIFICATE OF REGISTRATION

STATE OF OREGON

County of Marion } ss.

This is to certify that the foregoing Registration Statement was received in the office of the State Engineer on the 1st day of August, 1958, at 12¹² o'clock A.M. and has been duly recorded in said office in Book No. 14 of Registration Statements on page GR 3323

Witness my hand this 20th day of July, 1959

Lewis A. Stanley
(State Engineer)

By _____ (Deputy)

GR - **3323**

#15.00