

Registration Statement

OF CLAIMANT OF RIGHT TO APPROPRIATE GROUND WATER

TO THE STATE ENGINEER OF OREGON:

I, Elmer Stoller
of 14025 N.W. Bairlow Rd County of Washington
(Mailing address)

State of, do hereby make application for a certificate of registration as evidence of a right to appropriate ground water.

1. Source from which water is withdrawn is Pump Well
(Flowing well, pump well, infiltration trench, or tunnel)
2. Location is: 3 Mi. N. Cedar mill
(Approximate distance and direction from nearest city or town)

and is more particularly described as follows:

(a) 20657' 331° 30' To
(Give distance and bearing to corner of section or other legal subdivision)
being within S.W. 1/4 of Sec 21 of Sec. 21, Twp. 1N, Rge. 1W
(Smallest legal subdivision) (N., S., E. or W.)

or (b) within limits of recorded platted property, town or city:

in Lot _____ Block _____ of _____
(Name of plat or addition)
County of Washington
(If within city or town, give name)

3. Construction Work was begun on Jan 1955, was completed on Feb. 1955
(Date) (Date)

and the ground water claimed was first used for the purposes set out below on Feb. 1955
(Date)

since which time the water has been used Continuously
(Continuously or intermittently)

from Feb. 1955 to July 1958
(Date) (Date)

4. Quantity of water claimed and used is 130 gallons per minute; _____ acre feet per year.

5. Purpose or Purposes for which water is used irrigation
(Domestic, irrigation, municipal, manufacturing, industrial, etc.)

6. Description of Well: Depth 334 feet. Type drilled
(Dug or drilled)
diameter 8 inches. Elevation of ground at well site 200 feet, mean sea level.
(As near as known)
Depth to water table 21 feet.

7. Capacity of Well: 130 g.p.m. with 100 feet drawdown.
_____ g.p.m. with _____ feet drawdown.

Date of test Feb 1955

If Flowing Well: Measured discharge _____ g.p.m. on _____
(Date)

Shut-in pressure at ground surface _____ lbs. per sq. in. on _____
(Date)

Water is controlled by _____
(Cap., valve, etc.)

8. Casing: (Give diameter, commercial specifications and depth below ground surface of each casing size.)

8 inch diameter from 0 to 261 feet
 inch diameter from to feet
 inch diameter from to feet
 inch diameter from to feet

Describe and show depth of shoe, plug, adapter, liner or other details:

9. Perforated Casings or Screens:

(Number per foot and size of perforations, or describe screen)

from to
 from to
 from to
 from to

10. Log of Well: (Describe each stratum or formation clearly, indicate if water bearing, and give thickness and depth as indicated.)

MATERIAL	Thickness (Feet)	Depth to Bottom (Feet)
Rock + clay	261	
soft loam	261 - 297	
hard basalt	297 - 301	
Water bearing material	301 - 308	

If log of well is not available, give name and address of driller.

11. Infiltration Trench: Covered or open

Dimensions: Length ft. Minimum depth ft. Maximum depth ft.

Bottom width ft. Discharge g.p.m. Date of test

12. Tunnel: Type of lining

Dimensions:
(Length, course, and cross sectional size)

Position of water bearing stratum with reference to portal of tunnel

Log of tunnel: (Preceding table for log of well may be used, if desired. Give footage from portal and character of materials, as pertinent.)

13. Pumping Equipment:

(a) Pump *Hand - Jet* Capacity *17* g.p.m.
(Make, type and size)


(b) Motor *1 - Horse* *Electric*
(Type and horsepower)

14. Location of area irrigated or to be irrigated, or place of use if for purposes other than irrigation.

Township North or South	Range E. or W. of Willamette Meridian	Section	Forty-acre Tract	Number Acres To Be Irrigated	Date of Reclamation
<i>1N</i>	<i>1W</i>	<i>21</i>	<i>SW 1/4 of N. 1/4 of E. 1/4</i>	<i>1.0</i>	<i>Feb. 1955</i>

15. If the ground water supply is supplemental to an existing water supply, identification of any application for a permit, permit, certificate or adjudicated right to appropriate water made or held by the registrant.

Township 1N Range 1W W.M.
North

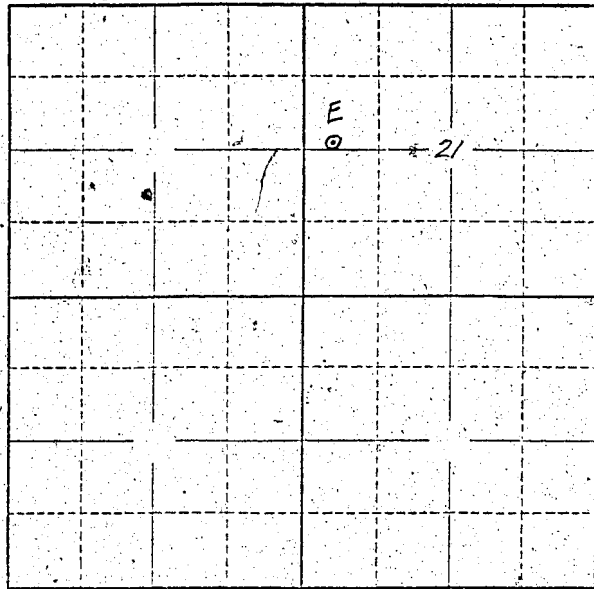

Locate well and acreage of irrigated land on plat.
Scale: 2" = 1 Mile

STATE OF OREGON

County of Washington } ss.


(Signature of Registrant)

Subscribed and sworn to before me this 21st day of July 1950

My commission expires _____
(Notary Public)

(SEAL)

CERTIFICATE OF REGISTRATION

STATE OF OREGON

County of Marion } ss.

This is to certify that the foregoing Registration Statement was received in the office of the State Engineer on the _____ day of _____, 19____, at _____ o'clock _____ M. and has been duly recorded in said office in Book No. 14 of Registration Statements on page OR-3328

Witness my hand this 20th day of August 1959

\$15.00

(State Engineer)

By _____
(Deputy)

GR - 3328