

# Registration Statement

## OF CLAIMANT OF RIGHT TO APPROPRIATE GROUND WATER

TO THE STATE ENGINEER OF OREGON:

I, Katheryn Hanley Heffernan

of Route 2, Box 401, Medford County of Jackson

State of Oregon, do hereby make application for a certificate of registration as evidence of a right to appropriate ground water.

1. Source from which water is withdrawn is pump well  
(Flowing well, pump well, infiltration trench, or tunnel)

2. Location is: 2 1/2 miles N. E. of Jacksonville, Oregon  
(Approximate distance and direction from nearest city or town)

and is more particularly described as follows:

(a) ~~Section 1/4 of NE 1/4~~ 779 ft. S. of N. W. cor. of S. 22, T. 3 S. R. 2 W of W.  
(Give distance and bearing to corner of section or other legal subdivision)

being within 1/4 of NE 1/4 of Sec. 22, Twp. 2, Rge. 2  
(Smallest legal subdivision) (S. or S.), (E. or W.)

or (b) within limits of recorded platted property, town or city:

in Lot \_\_\_\_\_, Block \_\_\_\_\_ of \_\_\_\_\_  
(Name of plat or addition)

County of \_\_\_\_\_  
(If within city or town, give name)

3. Construction Work was begun on 1934; was completed on 1934, recased in 1957  
(Date) (Date)

and the ground water claimed was first used for the purposes set out below on 1934  
(Date)

since which time the water has been used continuously  
(Continuously or intermittently)

from 1934 to 1958  
(Date) (Date)

4. Quantity of water claimed and used is 15 gal. gallons per minute; \_\_\_\_\_ acre feet per year.

5. Purpose or Purposes for which water is used domestic and garden over 1/2 Acre  
(Domestic, irrigation, municipal, manufacturing, industrial, etc.)

6. Description of Well: Depth 24 feet. Type dug  
(Dug or drilled)

diameter 12 inches. Elevation of ground at well site \_\_\_\_\_ feet, mean sea level.  
(As near as known)

Depth to water table 16 feet.

7. Capacity of Well: \_\_\_\_\_ g.p.m. with full feet drawdown.

\_\_\_\_\_ g.p.m. with \_\_\_\_\_ feet drawdown.

Date of test \_\_\_\_\_

If Flowing Well: Measured discharge \_\_\_\_\_ g.p.m. on \_\_\_\_\_  
(Date)

Shut-in pressure at ground surface \_\_\_\_\_ lbs. per sq. in. on \_\_\_\_\_  
(Date)

Water is controlled by \_\_\_\_\_  
(Cap, valve, etc.)

8. Casing: (Give diameter, commercial specifications and depth below ground surface of each casing size.)

..... inch diameter ..... from ..... to ..... feet  
..... inch diameter ..... from ..... to ..... feet  
..... inch diameter ..... from ..... to ..... feet  
..... inch diameter ..... from ..... to ..... feet

Describe and show depth of shoe, plug, adapter, liner or other details: .....

9. Perforated Casings or Screens:

(Number per foot and size of perforations, or describe screen) from ..... to .....  
..... from ..... to .....  
..... from ..... to .....  
..... from ..... to .....

10. Log of Well: (Describe each stratum or formation clearly, indicate if water bearing, and give thickness and depth as indicated.)

MATERIAL	Thickness (Feet)	Depth to Bottom (Feet)

If log of well is not available, give name and address of driller. ....

11. Infiltration Trench: Covered or open .....

Dimensions: Length ..... ft. Minimum depth ..... ft. Maximum depth ..... ft.

Bottom width ..... ft. Discharge ..... g.p.m. Date of test .....

12. Tunnel: Type of lining .....

Dimensions: .....  
(Length, course, and cross sectional size)

Position of water bearing stratum with reference to portal of tunnel .....

Log of tunnel: (Preceding table for log of well may be used, if desired. Give footage from portal and character of materials, as pertinent.)

13. Pumping Equipment:

(a) Pump 2" Viking ..... Capacity 50 g.p.m.  
(Make, type and size)


(b) Motor Single Phase motor 220 Volt 3 hp. 1750 rpm. Fairbanks-Morse  
 repulsion-induction.  
(Type and horsepower)

14. Location of area irrigated or to be irrigated, or place of use if for purposes other than irrigation.

Township North or South	Range E. or W. of Willamette Meridian	Section	Forty-acre Tract	Number Acres To Be Irrigated	Date of Reclamation
T 37 S	R2W	21	NE 1/4 of NE 1/4	2 acres	1934

15. If the ground water supply is supplemental to an existing water supply, identification of any application for a permit, permit, certificate or adjudicated right to appropriate water made or held by the registrant.  
 Not supplemental to any existing water supply.....

Township 37 S Range 2 W, W.M.  
North

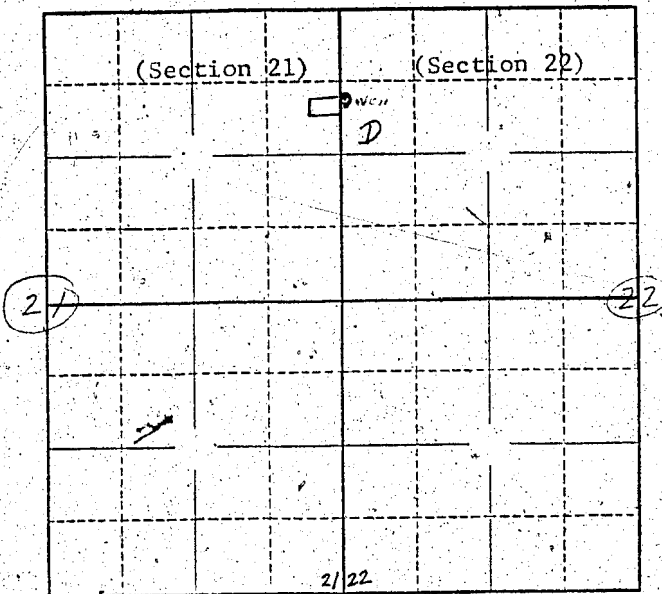

Locate well and acreage of irrigated land on plat.

Scale: 2" = 1 Mile

STATE OF OREGON

County of Jackson

ss.

I, Katheryn Hanley Heffernan, being first duly sworn, do hereby certify that I have read the foregoing Registration Statement and that all of the items therein contained are true to the best of my knowledge and belief.

(Signature of Registrant)

Subscribed and sworn to before me this 31st day of July, 1958

My commission expires

(Notary Public)

(SEAL)

**CERTIFICATE OF REGISTRATION**

STATE OF OREGON

County of Marion

ss.

This is to certify that the foregoing Registration Statement was received in the office of the State Engineer on the 14th day of August, 1959, at 12:00 o'clock P.M. and has been duly recorded in said office in Book No. 14 of Registration Statements on page GR-3329

Witness my hand this 20th day of August, 1959

(State Engineer)

By

(Deputy)

\$15.00

GR-3329