

# Registration Statement

## OF CLAIMANT OF RIGHT TO APPROPRIATE GROUND WATER

TO THE STATE ENGINEER OF OREGON:

I, Calvin A. Lee  
of 3230 Bell Ave, Eugene County of Lane  
(Mailing address)

State of Oregon, do hereby make application for a certificate of registration as evidence of a right to appropriate ground water.

1. Source from which water is withdrawn is ground well  
(Flowing well, pump well, infiltration trench, or tunnel)

2. Location is: 2 miles NW of Irving  
(Approximate distance and direction from nearest city or town)

and is more particularly described as follows:

(a) 2 miles north-west of Irving 250' S of the N line & 250' W of the E line  
(Give distance and bearing to corner of section or other legal subdivision)

being within Northeast quarter of Sec. 5, Twp. 17N, Rge. 12E  
(Smallest legal subdivision) (N. or S.) (E. or W.)

or (b) within limits of recorded platted property, town or city:

in Lot \_\_\_\_\_, Block \_\_\_\_\_ of \_\_\_\_\_  
(Name of plat or addition)

County of \_\_\_\_\_  
(If within city or town, give name)

3. Construction Work was begun on Oct. 1, 1953; was completed on Nov. 1, 1953  
(Date) (Date)

and the ground water claimed was first used for the purposes set out below on 1954  
(Date)

since which time the water has been used continuously  
(Continuously or Intermittently)

from May 1954 to present time  
(Date) (Date)

4. Quantity of water claimed and used is 35 gallons per minute; 60 acre feet per year.

5. Purpose or Purposes for which water is used irrigation

(Domestic, irrigation, municipal, manufacturing, industrial, etc.)

6. Description of Well: Depth 21 feet. Type drilled  
(Dug or drilled)

diameter 6 inches. Elevation of ground at well site 380 feet, mean sea level.  
(As near as known)

Depth to water table 15 feet.

7. Capacity of Well: 180 g.p.m. with \_\_\_\_\_ feet drawdown.

\_\_\_\_\_ g.p.m. with \_\_\_\_\_ feet drawdown.

Date of test June, 1958

If Flowing Well: Measured discharge \_\_\_\_\_ g.p.m. on \_\_\_\_\_  
(Date)


Shut-in pressure at ground surface \_\_\_\_\_ lbs. per sq. in. on \_\_\_\_\_  
(Date)

Water is controlled by \_\_\_\_\_  
(Cap, valve, etc.)





Township 17S Range 4W W.M.  
North

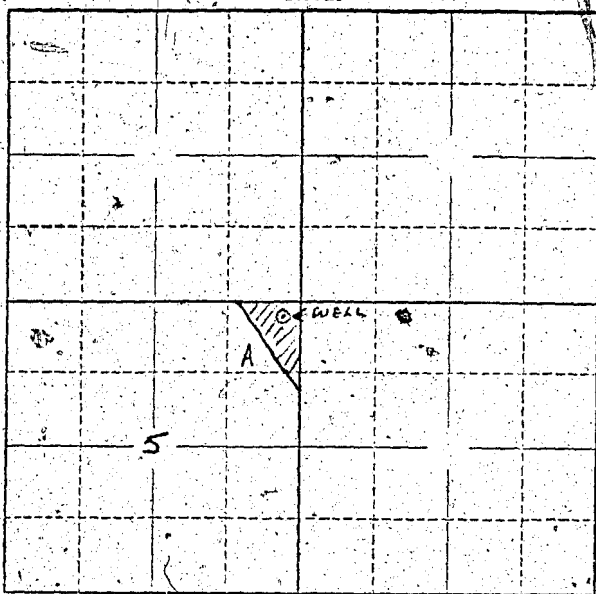

Locate well and acreage of irrigated land, on plat.  
Scale: 2" = 1 Mile

STATE OF OREGON

County of Marion } ss.

I, Robert R. [Signature], being first duly sworn, do hereby certify that I have read the foregoing Registration Statement and that all of the items therein contained are true to the best of my knowledge and belief.

[Signature]  
(Signature of Registrant)

Subscribed and sworn to before me this 21 day of July, 1955

My commission expires July 28, 1958

[Signature]  
(Notary Public)

(SEAL)

**CERTIFICATE OF REGISTRATION**

STATE OF OREGON

County of Marion } ss.

This is to certify that the foregoing Registration Statement was received in the office of the State Engineer on the 15<sup>th</sup> day of August, 1955, at 10 o'clock AM and has been duly recorded in said office in Book No. 14 of Registration Statements on page (p. 3330)

Witness my hand this 20<sup>th</sup> day of August, 1959

[Signature]  
(State Engineer)

By \_\_\_\_\_ (Deputy)

15.00