

# Registration Statement

## OF CLAIMANT OF RIGHT TO APPROPRIATE GROUND WATER

TO THE STATE ENGINEER OF OREGON:

I, LINO CARTASEGNA & SONS <sup>CO</sup> TINO CARTASEGNA  
of 6820 SE MAPLEHURST ROAD MILWAUKIE County of CLATSOP  
(Mailing address)

State of OREGON do hereby make application for a certificate of registration as evidence of a right to appropriate ground water.

1. Source from which water is withdrawn is Pump Well  
(Flowing well, pump well, infiltration trench, or tunnel)

2. Location is: 3 mi. East of Milwaukie  
(Approximate distance and direction from nearest city or town)

and is more particularly described as follows:

(a) S 50° 15' W, 4205' from NE Cor. Sec. 32, T. 15 - R. 2E  
(Give distance and bearing to corner of section or other legal subdivision)

being within NE 1/4 SW 1/4 of Sec. 32, Twp. 15, Rge. 2E  
(Smallest legal subdivision) (N. or S.) (E. or W.)

or (b) within limits of recorded platted property, town or city:

in Lot \_\_\_\_\_, Block \_\_\_\_\_ of \_\_\_\_\_  
(Name of plat or addition)

County of \_\_\_\_\_  
(If within city or town, give name)

3. Construction Work was begun on May 3, 1953; was completed on March 6, 1953  
(Date) (Date)

and the ground water claimed was first used for the purposes set out below on June 1, 1953  
(Date)

since which time the water has been used Continuously  
(Continuously or intermittently)

from June 1, 1953 to July 31, 1958  
(Date) (Date)

4. Quantity of water claimed and used is 150 gallons per minute; \_\_\_\_\_ acre feet per year.

5. Purpose or Purposes for which water is used IRRIGATION

(Domestic, irrigation, municipal, manufacturing, industrial, etc.)

6. Description of Well: Depth 270 feet. Type Drilled  
(Dug or drilled)

diameter 8 inches. Elevation of ground at well site 180 feet, mean sea level.  
(As near as known)

Depth to water table 65 feet.

7. Capacity of Well: 150 g.p.m. with 50 feet drawdown.

\_\_\_\_\_ g.p.m. with \_\_\_\_\_ feet drawdown.

Date of test 3-6-53

If Flowing Well: Measured discharge \_\_\_\_\_ g.p.m. on \_\_\_\_\_  
(Date)

Shut-in pressure at ground surface \_\_\_\_\_ lbs. per sq. in. on \_\_\_\_\_  
(Date)

Water is controlled by \_\_\_\_\_  
(Cap, valve, etc.)

8. Casing: (Give diameter, commercial specifications and depth below ground surface of each casing size.)

8 inch diameter *Standard pipe and welded joints* from 0 to 26 5/8" feet  
— inch diameter from to feet  
— inch diameter from to feet  
— inch diameter from to feet

Describe and show depth of shoe, plug, adapter, liner or other details: *Standard drive shoe*

9. Perforated Casings or Screens:

4 perforations per foot  $\frac{3}{16} \times \frac{1}{2}$  " from 90 to 157  
(Number per foot and size of perforations, or describe screen)  
" " " " " from 200 to 265  
" " " " " from — to —  
" " " " " from — to —

10. Log of Well: (Describe each stratum or formation clearly, indicate if water bearing, and give thickness and depth as indicated.)

MATERIAL	Thickness (Feet)	Depth to Bottom (Feet)
<i>Clay</i>	<i>26</i>	<i>26</i>
<i>brown sand</i>	<i>5</i>	<i>31</i>
<i>Cement gravel</i>	<i>95</i>	<i>126</i>
<i>Clay &amp; gravel</i>	<i>14</i>	<i>140</i>
<i>Sand &amp; gravel (water bearing)</i>	<i>17</i>	<i>157</i>
<i>Yellow brown &amp; blue Clay</i>	<i>44</i>	<i>201</i>
<i>Clay &amp; gravel</i>	<i>28</i>	<i>229</i>
<i>dirty sand &amp; some water</i>	<i>4</i>	<i>233</i>
<i>Cement gravel</i>	<i>18</i>	<i>251</i>
<i>loosely cemented gravel</i>	<i>19</i>	<i>270</i>

If log of well is not available, give name and address of driller.....

11. Infiltration Trench: Covered or open .....

Dimensions: Length ..... ft. Minimum depth ..... ft. Maximum depth ..... ft.  
Bottom width ..... ft. Discharge ..... g.p.m. Date of test .....

12. Tunnel: Type of lining .....

Dimensions: .....  
(Length, course, and cross sectional size)

Position of water bearing stratum with reference to portal of tunnel .....

Log of tunnel: (Preceding table for log of well may be used, if desired. Give footage from portal and character of materials, as pertinent.)

13. Pumping Equipment:


(a) Pump *Romona turbine* <sup>15</sup> *H.P. Electric* Capacity *150* g.p.m.  
(Make, type and size)  
(b) Motor .....  
(Type and horsepower)

14. Location of area irrigated or to be irrigated, or place of use if for purposes other than irrigation.

Township North or South	Range E. or W. of Willamette Meridian	Section	Forty-acre Tract	Number Acres To Be Irrigated	Date of Reclamation
15	2E	32	SE 1/4 NW 1/4	13	1953
15	2E	33	SW 1/4 NW 1/4	7	"
15	2E	33	NW 1/4 SW 1/4	12	"
15	2E	33	NE 1/4 SW 1/4	22	"
				54.0 Ac	"

15. If the ground water supply is supplemental to an existing water supply, identification of any application for a permit, permit, certificate or adjudicated right to appropriate water made or held by the registrant.  
*none*

Township 15 Range 2E W.M.  
North

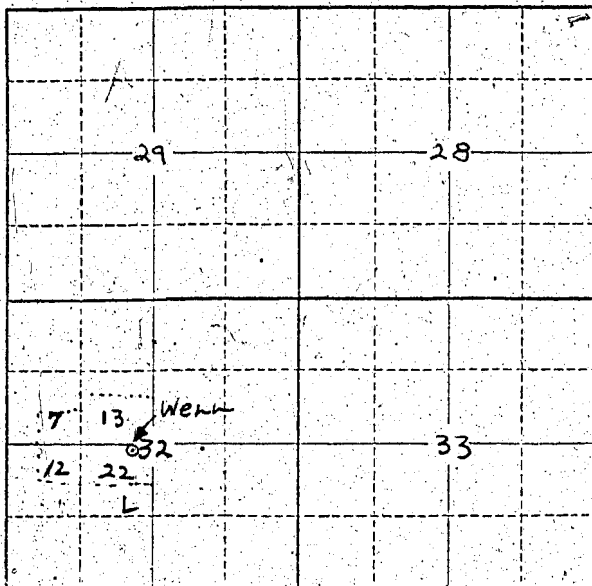

Locate well and acreage of irrigated land on plat.  
Scale: 2" = 1 Mile

STATE OF OREGON

County of Clatsop } ss.

I, Joe Cantasigna, being first duly sworn, do hereby certify that I have read the foregoing Registration Statement and that all of the items therein contained are true to the best of my knowledge and belief.

Joe Cantasigna  
(Signature of Registrant)

Subscribed and sworn to before me this 31 day of Aug, 1958

My commission expires Jan 1 1959  
(Notary Public)

(SEAL)

**CERTIFICATE OF REGISTRATION**

STATE OF OREGON

County of Marion } ss.

This is to certify that the foregoing Registration Statement was received in the office of the State Engineer on the 17 day of August, 1958, at 11:00 o'clock AM and has been duly recorded in said office in Book No. 14 of Registration Statements on page GR-3335

Witness my hand this 20<sup>th</sup> day of August, 1959

# 18.60

W. A. Atchley  
(State Engineer)

By \_\_\_\_\_ (Deputy)