

REGISTRATION NO. OP-365CERTIFICATE NO. OR 351**Registration Statement****OF CLAIMANT OF RIGHT TO APPROPRIATE GROUND WATER**

(Under Chapter 708, Oregon Laws 1955.)

TO THE STATE ENGINEER OF OREGON:I, RESTLAWN MEMORY GARDENS, INC.of 677 N. Cottage St. Salem, County of MarionState of Oregon, do hereby make application for a certificate of registration as evidence of a right to appropriate ground water.1. Source from which water is withdrawn is Pump Well #1
(Flowing well, pump well, infiltration trench, or tunnel)2. Location is: On highway 22 app. 6 miles west of Salem (in Polk County)
(Approximate distance and direction from nearest city or town)

and is more particularly described as follows:

(a) 2800 feet South & 1000 feet East from NW corner of section 26
S. 37° 15' E. 570 ft. from Initial Point of Sunset Garden as recorded in Vol. 5
(Give distance and bearing to corner of section or other legal subdivision) of town plats page 1
being within N. W. 1/4 of S. W. 1/4 of Sec. 26, Twp. 7 S. 0, Rge. 4 W.
(Smallest legal subdivision) (N. or S.) (E. or W.)

or (b) within limits of recorded platted property, town or city:

in Lot _____, Block _____ of _____
(Name of plat or addition)

(If within city or town, give name) _____ County of _____

3. Construction Work was begun on Spring 1953; was completed on Same
(Date) (Date)and the ground water claimed was first used for the purposes set out below on Same
(Date)since which time the water has been used Intermittently
(Continuously or intermittently)from Spring 1953 to 1956
(Date) (Date)4. Quantity of water claimed and used is 10 gallons per minute; 1 acre feet per year.5. Purpose or Purposes for which water is used Irrigation

(Domestic, irrigation, municipal, manufacturing, industrial, etc.)

6. Description of Well: Depth 140 feet. Type Drilled
(Dug or drilled)diameter 8 inches. Elevation of ground at well site 207 feet, mean sea level.
(As near as known)Depth to water table 200 20 feet.7. Capacity of Well: 10 g.p.m. with total feet drawdown.

_____ g.p.m. with _____ feet drawdown.

Date of test _____

If Flowing Well: Measured discharge _____ g.p.m. on _____
(Date)Shut-in pressure at ground surface _____ lbs. per sq. in. on _____
(Date)Water is controlled by _____
(Cap, valve, etc.)

8. **Casing:** (Give diameter, commercial specifications and depth below ground surface of each casing size.)

8	inch diameter	Std. steel pipe	from 0	to 140	feet
	inch diameter		from	to	feet
	inch diameter		from	to	feet
	inch diameter		from	to	feet

Describe and show depth of shoe, plug, adapter, liner or other details: _____

9. Perforated Casings or Screens:

Unavailable	from	to
(Number per foot and size of perforations, or describe screen)		
	from	to
	from	to
	from	to
	from	to

10. Log of Well: (Describe each stratum or formation clearly, indicate if water bearing, and give thickness and depth as indicated.)

[illegible]

Now residing in California

Dimensions: Length ft. Minimum depth ft. Maximum depth ft.


12. Tunnel: Type of lining

Position of water bearing stratum with reference to portal of tunnel

13. Pumping Equipment:

(b) Motor 1 H. P.
(Type and horsepower)

Township 7 S Range 4 N W.M.
North

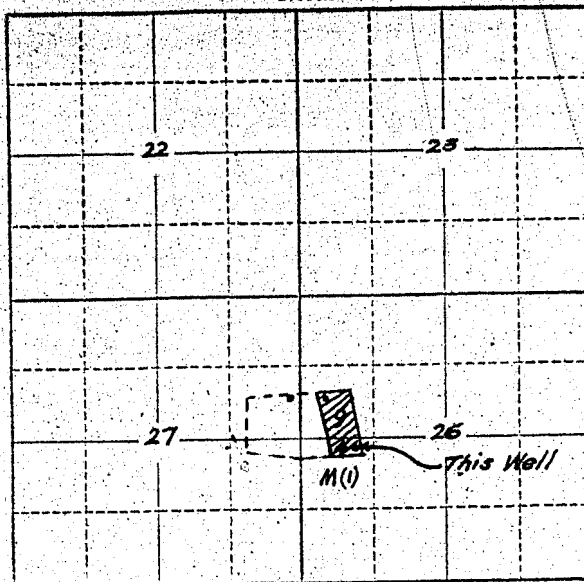

Locate well and acreage of irrigated land on plat.
Scale: 2" = 1 Mile

STATE OF OREGON

County of _____

ss.

I, L. Dale Emery, being first duly sworn, do hereby certify that I have read the foregoing Registration Statement and that all of the items therein contained are true to the best of my knowledge and belief.

L. Dale Emery
(Signature of Registrant)

Subscribed and sworn to before me this 7th day of February, 1957

My commission expires _____

(Notary Public)

(SEAL)

See Page GR-351 K for
CERTIFICATE OF REGISTRATION

STATE OF OREGON

County of Marion

ss.


Witness my hand this _____ day of _____, 1957

(State Engineer)

By _____

(Deputy)

GR 351 C

②

REGISTRATION NO. GR-365

Registration Statement CERTIFICATE NO. GR 351

OF CLAIMANT OF RIGHT TO APPROPRIATE GROUND WATER

(Under Chapter 708, Oregon Laws 1955.)

TO THE STATE ENGINEER OF OREGON:

I, RESTLAWN MEMORY GARDENS, INC.

of 677 N. Cottage County of Marion

State of Oregon, do hereby make application for a certificate of registration as evidence of a right to appropriate ground water.

1. Source from which water is withdrawn is Pump Well #2
(Flowing well, pump well, infiltration trench, or tunnel)

2. Location is: On highway 22 app. 6 miles west of Salem (in Polk Co.)
(Approximate distance and direction from nearest city or town)

and is more particularly described as follows:

(a) 2000 feet South and 600 feet East from NW corner of section 26
N. 70° 40' W. 550 Ft. from the initial point of Sunset Garden as recorded in Vol. 5
(Give distance and bearing to corner of section or other legal subdivision) of town plats page 1

being within S. W. 1/4 of the N. W. 1/4 of Sec. 26, Twp. 7S, Rge. 4W
(Smallest legal subdivision) (N. or S.) (E. or W.)

or (b) within limits of recorded platted property, town or city:

in Lot _____, Block _____ of _____
(Name of plat or addition)

County of _____
(If within city or town, give name)

3. Construction Work was begun on Feb. '54; was completed on March '54
(Date) (Date)

and the ground water claimed was first used for the purposes set out below on May 1954
(Date)

since which time the water has been used Intermittently
(Continuously or intermittently)

from May '54 to 1956
(Date) (Date)

4. Quantity of water claimed and used is 8 gallons per minute; 3/4 acre feet per year.

5. Purpose or Purposes for which water is used Irrigation
(Domestic, irrigation, municipal, manufacturing, industrial, etc.)

6. Description of Well: Depth 155 feet. Type Drilled
(Dug or drilled)

diameter 8 inches. Elevation of ground at well site 230 feet, mean sea level.
(As near as known)

Depth to water table 140 feet.

7. Capacity of Well: 8 g.p.m. with total feet drawdown.

_____ g.p.m. with _____ feet drawdown.

Date of test _____

If Flowing Well: Measured discharge _____ g.p.m. on _____
(Date)

Shut-in pressure at ground surface _____ lbs. per sq. in. on _____
(Date)

Water is controlled by _____
(Cap, valve, etc.)


8	inch diameter	Std. Steel Pipe	from	0	to	155	feet
	inch diameter		from		to		feet
	inch diameter		from		to		feet
	inch diameter		from		to		feet

Describe and show depth of shoe, plug, adapter, liner or other details:

Not available	from	to
(Number per foot and size of perforations, or describe screen)		
	from	to
	from	to
	from	to
	from	to

[illegible]

Township 25 Range 4 N W.M.
North

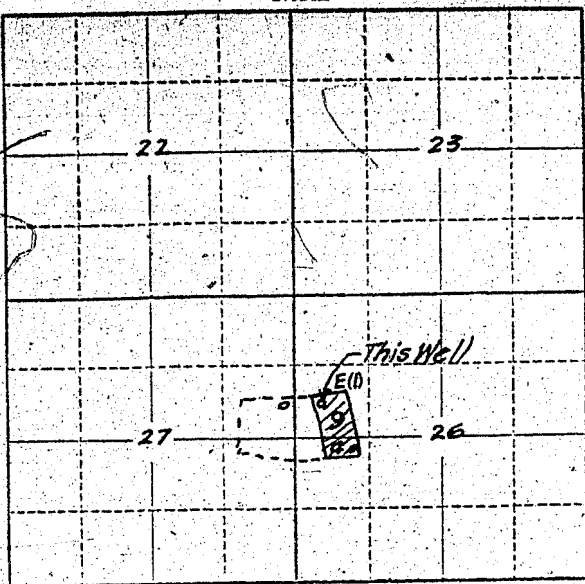

Locate well and acreage of irrigated land on plat.
Scale: 2" = 1 Mile

STATE OF OREGON

County of _____ } ss.

I, _____, being first duly sworn, do hereby certify that I have read the foregoing Registration Statement and that all of the items therein contained are true to the best of my knowledge and belief.

[Signature]
(Signature of Registrant)

Subscribed and sworn to before me this _____ day of _____, 19____

My commission expires _____

(Notary Public)

(SEAL)

See Page GR-351 K for
CERTIFICATE OF REGISTRATION

STATE OF OREGON

County of Marion } ss.


Witness my hand this _____ day of _____, 19____

(State Engineer)

By _____ (Deputy)

Registration Statement CERTIFICATE NO. 351

OF CLAIMANT OF RIGHT TO APPROPRIATE GROUND WATER

(Under Chapter 798, Oregon Laws 1955.)

TO THE STATE ENGINEER OF OREGON:

I, RESTLAWN MEMORY GARDENS, INC.of 677 N. Cottage County of MarionState of Oregon do hereby make application for a certificate of registration as evidence of a right to appropriate ground water.1. Source from which water is withdrawn is Pump well #3
(Flowing well, pump well, infiltration trench, or tunnel)2. Location is: On highway 22 app. 6 miles west of Salem (in Polk County)
(Approximate distance and direction from nearest city or town)

and is more particularly described as follows:

(a) N. 56° W. 980 Ft. from the initial point of Sunset Garden as recorded in Vol. 5
2020 feet South and 300 feet west from NW corner of section 26.
(Give distance and bearing to corner of section or other legal subdivisions of town plats page 1
Polk Co. Recordsbeing within S.E. 1/4 of N.E. 1/4 of Sec. 27, Twp. 7S, Rge. 4W
(Smallest legal subdivisions) (N. or S.) (E. or W.)

or (b) within limits of recorded platted property, town or city:

in Lot _____, Block _____ of _____
(Name of plat or addition)

(If within city or town, give name)

County of _____

3. Construction Work was begun on March 1955; was completed on March 1955
(Date) (Date)and the ground water claimed was first used for the purposes set out below on May 1955
(Date)since which time the water has been used intermittently
(Continuously or intermittently)from Mar. 1955 to 1956
(Date) (Date)4. Quantity of water claimed and used is 12 gallons per minute; 1 1/4 acre
feet per year.5. Purpose or Purposes for which water is used Irrigation

(Domestic, irrigation, municipal, manufacturing, industrial, etc.)

6. Description of Well: Depth 108 feet. Type Drilled

(Dug or drilled)

diameter 8 inches. Elevation of ground at well site 225 feet, mean sea level.

(As near as known)

Depth to water table 90 feet.7. Capacity of Well: 12 g.p.m. with total feet drawdown.

_____ g.p.m. with _____ feet drawdown.

Date of test _____

If Flowing Well: Measured discharge _____ g.p.m. on _____
(Date)Shut-in pressure at ground surface _____ lbs. per sq. in. on _____
(Date)Water is controlled by _____
(Cap, valve, etc.)



100


9. Perforated Casings or Screens:

(Number per foot and size of perforations, or describe screen)

ness and depth as indicated.)

No log furnished by driller
Stadeli & Son, Silverton

Township 7 S Range 4 W W.M.
North

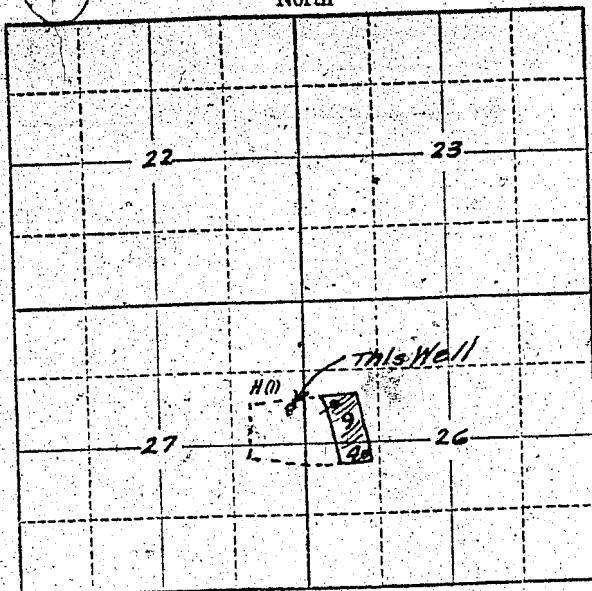

Locate well and acreage of irrigated land on plat.
Scale: 2" = 1 Mile

STATE OF OREGON

County of _____

ss.

I, L. Dale Emery, being first duly sworn, do hereby certify that I have read the foregoing Registration Statement and that all of the items therein contained are true to the best of my knowledge and belief.

L. Dale Emery
(Signature of Registrant)

Subscribed and sworn to before me this 7th day of February, 1957

My commission expires Sept. 8, 1960

Chas. J. Wheeler
(Notary Public)

(SEAL)

CERTIFICATE OF REGISTRATION

STATE OF OREGON

County of Marion

ss.

This is to certify that the foregoing Registration Statement was received in the office of the State Engineer on the 7th day of February, 1957 at 11:00 o'clock A. M. and has been duly recorded in said office in Book No. 2 of Registration Statements on page GR-351 K

~~Construction of this project is completed by xxxxxxxxxx and is completely applied to xxxxxxxx by xxxxxxxx to xxxxxxxx~~

Witness my hand this 30th day of April, 1957

Lewis A. Stanley
(State Engineer)

By _____

(Deputy)

GR 351 K

\$15.00