

RECEIVED
AUG 1 1958
STATE ENGINEER
SALEM, OREGON

REGISTRATION NO. GR-3651
CERTIFICATE NO. GR-4074

Registration Statement

OF CLAIMANT OF RIGHT TO APPROPRIATE GROUND WATER

(Under Chapter 708, Oregon Laws 1955.)

TO THE STATE ENGINEER OF OREGON:

I, Helen Hedrick for Norcross Ranch
of 503 S. Oakdale Madford County of Jackson

State of Oregon, do hereby make application for a certificate of registration as evidence of a right to appropriate ground water.

1. Source from which water is withdrawn is Sump
(Flowing well, pump well, infiltration trench, or tunnel)

2. Location is: one and one half miles (1 1/2) East of Central Point
(Approximate distance and direction from nearest city or town)

and is more particularly described as follows:

(a) Sump is located 1340' N. of 1480' E. from the N.W. Cor. D.M.C. # 56
(Give distance and bearing to corner of section or other legal subdivision)

being within SE 1/4 SW 1/4 NE 1/4 of Sec. 2, Twp. 37 S., Rge. 2 West
(Smallest legal subdivision) (N. or S.) (E. or W.)

or (b) within limits of recorded platted property, town or city:

in Lot _____, Block _____ of _____
(Name of plat or addition)

County of _____
(If within city or town, give name)

3. Construction Work was begun on Prior to 1908; was completed on Prior to 1908
was in existence prior to 1908 has been cleaned out and used
and the ground water claimed was first used for the purposes set out below on Prior to 1908
intermittently since that date by present owners and heirs
since which time the water has been used Intermittently
(Continuously or Intermittently)

from Prior to 1908 to Present
(Date) (Date)

4. Quantity of water claimed and used is 600 gallons per minute; 54 acre feet per year.

5. Purpose or Purposes for which water is used Irrigation of pear orchard

(Domestic, irrigation, municipal, manufacturing, industrial, etc.)

6. Description of Well: Depth 12 feet. Type Dug sump
(Dug or drilled)

diameter 40" X 40" Elevation of ground at well site 1255 feet, mean sea level.
(As near as known)

Depth to water table 10 feet.

7. Capacity of Well: _____ g.p.m. with _____ feet drawdown.

_____ g.p.m. with _____ feet drawdown.


Date of test _____

If Flowing Well: Measured discharge _____ g.p.m. on _____
(Date)

Shut-in pressure at ground surface _____ lbs. per sq. in. on _____
(Date)

Water is controlled by _____
(Cap, valve, etc.)

Township 37S Range 2W, W.M.
North

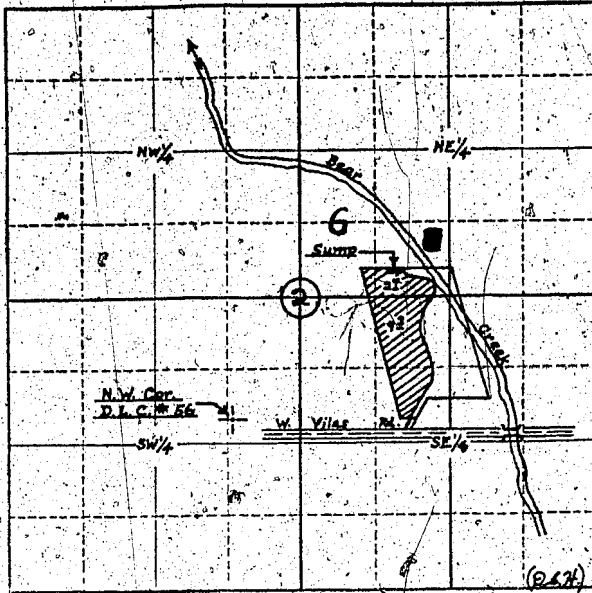

Locate well and acreage of irrigated land on plat.
Scale: 4" = 1 Mile

STATE OF OREGON

County of Jackson } ss.

I, Helen Hedrick being first duly sworn, do hereby certify that I have read the foregoing Registration Statement and that all of the items therein contained are true to the best of my knowledge and belief.

By: Helen Hedrick
(Signature of Registrant)

Subscribed and sworn to before me this 31st day of July, 1958

My commission expires October 7, 1961

[Signature]
(Notary Public)

(SEAL)

CERTIFICATE OF REGISTRATION

STATE OF OREGON

County of Marion } ss.

This is to certify that the foregoing Registration Statement was received in the office of the State Engineer on the 15th day of August, 1958, at 8:00 o'clock A. M. and has been duly recorded in said office in Book No. 17 of Registration Statements on page GR 4074

~~xx Construction shall be completed by 1960 and the water completely applied to beneficial use by 1963 xx~~

Witness my hand this 16th day of May, 1960

LEWIS A. STANLEY
(State Engineer)

By: Max F. Rogers
(Deputy)

GR-4074

\$15.00