

Registration Statement

OF CLAIMANT OF RIGHT TO APPROPRIATE GROUND WATER

(Under Chapter 708, Oregon Laws 1955.)

TO THE STATE ENGINEER OF OREGON:

I, River + Credley Hayes
of River Road, Junction City County of Lane

State of Oregon, do hereby make application for a certificate of registration as evidence of a right to appropriate ground water.

1. Source from which water is withdrawn is _____
(Flowing well, pump well, infiltration trench, or tunnel)

2. Location is: 3/2 miles S.E. Junction City
(Approximate distance and direction from nearest city or town)

and is more particularly described as follows:

(a) 870 feet west + 900 feet North from SE corner Section 9
(Give distance and bearing to corner of section or other legal subdivision)

being within SE 1/4 of SE 1/4 of Sec. 9 Twp. 16 S, Rge. 11 W
(Smallest legal subdivision) (or S.) (or W.)

or (b) within limits of recorded platted property, town or city: _____

in Lot _____ Block _____ of _____
(Name of plat or addition)

County of _____
(If within city or town, give name)

3. Construction Work was begun on June 15; was completed on July 10 1947
(Date) (Date)

and the ground water claimed was first used for the purposes set out below on 1947
(Date)

since which time the water has been used each year
(Continuously or intermittently)

from June 15 to July 15
(Date) (Date)

4. Quantity of water claimed and used is 1000 gallons per minute; 2 1/2 acre feet per year.

5. Purpose or Purposes for which water is used irrigation

domestic use
(Domestic, irrigation, municipal, manufacturing, industrial, etc.)

6. Description of Well: Depth 21 feet. Type Screen Steel pipe
(Dug or drilled)

diameter 6 in inches. Elevation of ground at well site _____ feet; mean sea level.

Depth to water table: 8 feet.

7. Capacity of Well: _____ g.p.m. with _____ feet drawdown.

1000 g.p.m. with _____ feet drawdown.

Date of test: _____

If Flowing Well: Measured discharge _____ g.p.m. on _____
(Date)

Shut-in pressure at ground surface _____ lbs. per sq. in. on _____
(Date)

Water is controlled by _____
(Valve, etc.)

8. Casing: (Give diameter, commercial specifications and depth below ground surface of each casing size.)

6 inch diameter from to feet
 inch diameter from to feet
 inch diameter from to feet
 inch diameter from to feet

Describe and show depth of shoe, plug, adapter, liner or other details:

9. Perforated Casings or Screens:

respirator 6 feet from to
 (Number per foot and size of perforations, or describe screen)
 from to
 from to
 from to

10. Log of Well: (Describe each stratum or formation clearly, indicate if water bearing, and give thickness and depth as indicated.)

| | MATERIAL | Thickness (Feet) | Depth to Bottom (Feet) |
|--|----------|---------------------|---------------------------|
| | | | |
| | | | |
GR- 3316

If log of well is not available, give name and address of driller:

11. Infiltration Trench: Covered or open

Dimensions: Length ft. Minimum depth ft. Maximum depth ft.

Bottom width ft. Discharge g.p.m. Date of test

12. Tunnel: Type of lining

Dimensions:
(Length, course, and cross sectional size)

Position of water bearing stratum with reference to portal of tunnel

Log of tunnel: (Preceding table for log of well may be used, if desired. Give footage from portal and character of materials, as pertinent.)

13. Pumping Equipment:

(a) Pump *Centrifugal 5 inch* Capacity *1000* g.p.m.
(Make, type and size)

(b) Motor *20 H. 3 Phase*
(Type and horsepower)


14. Location of area irrigated or to be irrigated, or place of use if for purposes other than irrigation.

| Township North or South | Range E. or W. of Willamette Meridian | Section | Forty-acre Tract | Number Acres To Be Irrigated | Date of Reclamation |
|-------------------------|---------------------------------------|----------|-------------------------|------------------------------|----------------------|
| <i>T16 North</i> | <i>R11 W</i> | <i>9</i> | <i>SW 1/4 of SE 1/4</i> | <i>13</i> | <i>July 1st 1947</i> |
| " | " | <i>9</i> | <i>SE 1/4 of SE 1/4</i> | <i>14</i> | " |
| | | | | <i>27</i> | |
| | | | | | |
| | | | | | |
15. If the ground water supply is supplemental to an existing water supply, identification of any application for a permit, permit, certificate or adjudicated right to appropriate water made or held by the registrant.

Township 16S Range 4W W.M.

North

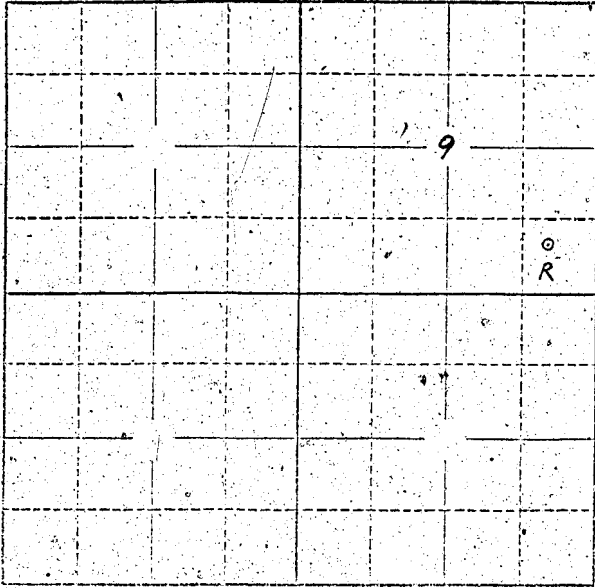

Locate well and acreage of irrigated land on plat.

Scale: 2" = 1 Mile

STATE OF OREGON

County of _____ ss.

I, Harold A. Hagen, being first duly sworn, do hereby certify that I have read the foregoing Registration Statement and that all of the items therein contained are true to the best of my knowledge and belief.

(Signature of Registrant)

Subscribed and sworn to before me this 31st day of July, 1959

My commission expires Apr 11 1960

(Notary Public)

(SEAL)

CERTIFICATE OF REGISTRATION

STATE OF OREGON }
County of Marion } ss.

This is to certify that the foregoing Registration Statement was received in the office of the State Engineer on the _____ day of _____, 19____, at _____ o'clock _____ M. and has been duly recorded in said office in Book No. 14 of Registration Statements on page GR-3216

~~Construction has been completed by _____ and the water has been placed beneficial use by _____~~

Witness my hand this 20th day of August, 1959

Edward J. Stanley
(State Engineer)

B
(Deputy)

#15.00

GR-3216