

Registration Statement

OF CLAIMANT OF RIGHT TO APPROPRIATE GROUND WATER

TO THE STATE ENGINEER OF OREGON:

I, Oscar R. Oakes
of 376 South Main Street (Mailing address) County of Clatsop
State of Oregon, do hereby make application for a certificate of registration as evidence of a right to appropriate ground water.

1. Source from which water is withdrawn is Flowing well
(Flowing well, pump well, infiltration trench, or tunnel)

2. Location is: One mile north of Junction City
(Approximate distance and bearing to corner of section or other legal subdivision)

and is more particularly described as follows:

(a) 800 E. 250 N. Farm
(Give distance and bearing to corner of section or other legal subdivision)

being within South Fork (Smallest legal subdivision) of Sec. 29, Twp. 13 S, Rge. 10 W
(or S.) (or W.)

or (b) within limits of recorded platted property, town or city:

in Lot _____, Block _____ of _____
(Name of plat or addition)

_____ County of Clatsop
(If within city or town, give name)

3. Construction Work was begun on 1958 (Date); was completed on _____ (Date)

and the ground water claimed was first used for the purposes set out below on _____ (Date)

since which time the water has been used _____ (Continuously or intermittently)

from March (Date) to May (Date)

4. Quantity of water claimed and used is _____ gallons per minute; _____ acre feet per year.

5. Purpose or Purposes for which water is used _____
(Domestic, irrigation, municipal, manufacturing, industrial, etc.)

6. Description of Well: Depth 21 feet. Type Flowing
(Dug or drilled)

diameter _____ inches. Elevation of ground at well site 310 feet, mean sea level.
(As near as known)

Depth to water table _____ feet.

7. Capacity of Well: _____ g.p.m. with _____ feet drawdown.

_____ g.p.m. with _____ feet drawdown.

Date of test NONE

If Flowing Well: Measured discharge _____ g.p.m. on _____ (Date)

Shut-in pressure at ground surface _____ lbs. per sq. in. on _____ (Date)

Water is controlled by _____
(Cap, valve, etc.)

8. Casing: (Give diameter, commercial specifications and depth below ground surface of each casing size.)

1 7/8 inch diameter from to feet
 inch diameter from to feet
 inch diameter from to feet
 inch diameter from to feet

Describe and show depth of shoe, plug, adapter, liner or other details:

9. Perforated Casings or Screens:

NCT K. from to
 (Number per foot and size of perforations, or describe screen)
 from to
 from to
 from to

10. Log of Well: (Describe each stratum or formation clearly, indicate if water bearing, and give thickness and depth as indicated.)

MATERIAL	Thickness (Feet)	Depth to Bottom (Feet)
not available		

If log of well is not available, give name and address of driller. W. K. ...

11. **Infiltration Trench:** Covered or open

Dimensions: Length ft. Minimum depth ft. Maximum depth ft.

Bottom width ft. Discharge g.p.m. Date of test

12. **Tunnel:** Type of lining

Dimensions:
(Length, course, and cross sectional size)

Position of water bearing stratum with reference to portal of tunnel

Log of tunnel: (Preceding table for log of well may be used, if desired. Give footage from portal and character of materials, as pertinent.)

13. **Pumping Equipment:**

(a) Pump Reciprocating 1 1/2 B.P. 2-11 Capacity g.p.m.
(Make, type and size)


(b) Motor General Electric 5 HP
(type and horsepower)

14. Location of area irrigated or to be irrigated, or place of use if for purposes other than irrigation.

Township North or South	Range E. or W. of Willamette Meridian	Section	Forty-acre Tract	Number Acres To Be Irrigated	Date of Reclamation
13-3	4W	27	SW 1/4 of NW 2	3.9	1952

15. If the ground water supply is supplemental to an existing water supply, identification of any application for a permit, permit, certificate or adjudicated right to appropriate water-made or held by the registrant.

Township 15 S Range 4 W, W.M.
North

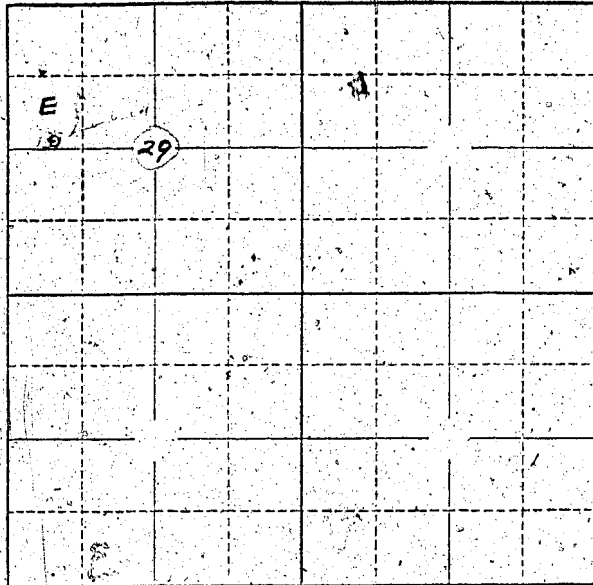

Locate well and acreage of irrigated land on plat.
Scale: 2" = 1 Mile

STATE OF OREGON }
County of Lane } ss.

I, Oscar R. Oakes, being first duly sworn, do hereby certify that I have read the foregoing Registration Statement and that all of the items therein contained are true to the best of my knowledge and belief.

Oscar R. Oakes
(Signature of Registrant)

Subscribed and sworn to before me this 30th day of July, 1958

My commission expires October 4, 1961.
Steve P. Tyler
(Notary Public)

(SEAL)

CERTIFICATE OF REGISTRATION

STATE OF OREGON }
County of Marion } ss.

This is to certify that the foregoing Registration Statement was received in the office of the State Engineer on the _____ day of _____, 1958, at _____ o'clock PM and has been duly recorded in said office in Book No. 14 of Registration Statements on page GR-3351

Witness my hand this 20th day of August, 1959
Steve A. Stanley
(State Engineer)

By _____
(Deputy)