

Registration Statement

OF CLAIMANT OF RIGHT TO APPROPRIATE GROUND WATER

TO THE STATE ENGINEER OF OREGON:

I, Wayne B. Smith

of 1500 Jager Lane, Rt. 3, Junction City County of Lane

(Mailing address)

State of OREGON, do hereby make application for a certificate of registration as evidence of a right to appropriate ground water.

1. Source from which water is withdrawn is Pump well
(Flowing well, pump well, infiltration trench, or tunnel)

2. Location is: 4 miles north of Junction City
(Approximate distance and direction from nearest city or town)

and is more particularly described as follows:

(a) 1200 ft. N., 925 ft. S. of northeast corner of Sec. 18
(Give distance and bearing to corner of section or other legal subdivision)

being within NE 1/4, NE 1/4 Lot 7 of Horston Plat of Sec. 18, Twp. 15 N., Rge. 4 E.
(Smallest legal subdivision) (N. or S.) (E. or W.)

or (b) within limits of recorded platted property, town or city:

in Lot _____, Block _____ of _____
(Name of plat or addition)

County of _____
(If within city or town, give name)

3. Construction Work was begun on unknown; was completed on or prior to 1945
(Date) (Date)

and the ground water claimed was first used for the purposes set out below on 1945
(Date)

since which time the water has been used intermittently
(Continuously or intermittently)

from 1945 to 1954
(Date) (Date)

4. Quantity of water claimed and used is 100 gallons per minute; 10 acre feet per year.

5. Purpose or Purposes for which water is used irrigation

(Domestic, irrigation, municipal, manufacturing, industrial, etc.)

6. Description of Well: Depth 20 feet. Type driven
(Dug or drilled)

diameter 4 inches. Elevation of ground at well site 590 feet, mean sea level.
(As near as known)

Depth to water table 10 feet.

7. Capacity of Well: unknown g.p.m. with unknown feet drawdown.

_____ g.p.m. with _____ feet drawdown.

Date of test _____

If Flowing Well: Measured discharge _____ g.p.m. on _____
(Date)

Shut-in pressure at ground surface _____ lbs. per sq. in. on _____
(Date)

Water is controlled by _____
(Cap, valve, etc.)

8. Casing: (Give diameter, commercial specifications and depth below ground surface of each casing size.)

..... inch diameter from to feet
..... inch diameter from to feet
..... inch diameter from to feet
..... inch diameter from to feet

Describe and show depth of shoe, plug, adapter, liner or other details:

9. Perforated Casings or Screens:

Since well was driven by someone unknown to us,
we can only presume it is similar to many others.

around ~~per~~ (number per foot and size of perforations, or describe screen) from to
Twenty 1/2 in. holes per ft. from 16 to 20 ft. depth
..... from to
..... from to

10. Log of Well: (Describe each stratum or formation clearly, indicate if water bearing, and give thickness and depth as indicated.)

MATERIAL	Thickness (Feet)	Depth to Bottom (Feet)
Unknown		

If log of well is not available, give name and address of driller. Unknown

11. Infiltration Trench: Covered or open

Dimensions: Length ft. Minimum depth ft. Maximum depth ft.

Bottom width ft. Discharge g.p.m. Date of test

12. Tunnel: Type of lining

Dimensions:
(Length, course, and cross sectional size)

Position of water bearing stratum with reference to portal of tunnel

Log of tunnel: (Preceding table for log of well may be used, if desired. Give footage from portal and character of materials, as pertinent.)

13. Pumping Equipment:

(a) Pump are in process of changing equipment - see attached note.
(Make, type and size) Capacity 100 g.p.m.

(b) Motor 7 1/2 HP Pump Motor (to be installed) Tractor used at Present
(Type and horsepower)

14. Location of area irrigated or to be irrigated, or place of use if for purposes other than irrigation.


Township North or South	Range E. or W. of Willamette Meridian	Section	Forty-acre Tract	Number Acres To Be Irrigated	Date of Reclamation
15	4 N	18	NE + SE	10	1945

15. If the ground water supply is supplemental to an existing water supply, identification of any application for a permit, permit, certificate or adjudicated right to appropriate water made or held by the registrant.

None

Township 12 S Range 4 W, W.M.

North

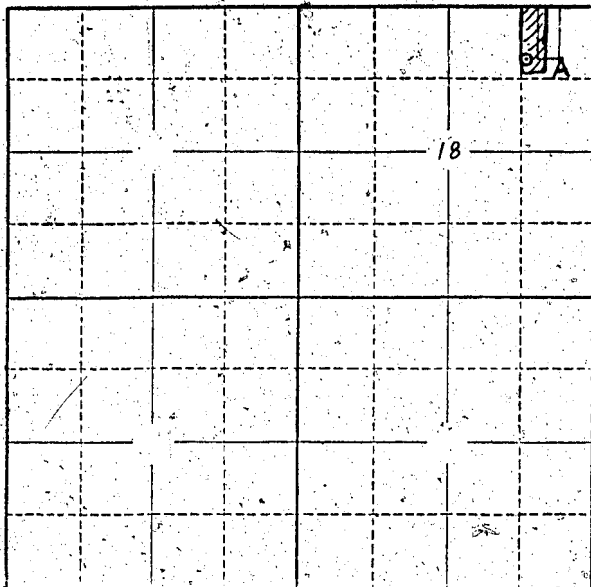

Locate well and acreage of irrigated land on plat.

Scale: 2" = 1 Mile

STATE OF OREGON

County of Lane } ss.

I, Wayne B. Smith, being first duly sworn, do hereby certify that I have read the foregoing Registration Statement and that all of the items therein contained are true to the best of my knowledge and belief.

Wayne B. Smith
(Signature of Registrant)

Subscribed and sworn to before me this 31st day of July, 19 58

My commission expires March 13, 1961

Ernest D. Rose
(Notary Public)

(SEAL)

CERTIFICATE OF REGISTRATION

STATE OF OREGON

County of Marion } ss.

This is to certify that the foregoing Registration Statement was received in the office of the State Engineer on the 13th day of August, 19 58, at 8:00 o'clock A. M. and has been duly recorded in said office in Book No. 14 of Registration Statements on page GR-3359

Witness my hand this 20th day of August, 19 59

Lewis A. Stanley
(State Engineer)

By _____ (Deputy)

15.00

GR - 3359