



8. Casing: (Give diameter, commercial specifications and depth below ground surface of each casing size.)

4 inch diameter ..... from 0 to 20 feet  
 ..... inch diameter ..... from 0 to ..... feet  
 ..... inch diameter ..... from ..... to ..... feet  
 ..... inch diameter ..... from ..... to ..... feet

Describe and show depth of shoe, plug, adapter, liner or other details: .....

9. Perforated Casings or Screens:

*Slotted* ..... from 17' to 20' .....  
 (Number per foot and size of perforations, or describe screen)  
 ..... from ..... to .....  
 ..... from ..... to .....  
 ..... from ..... to .....

10. Log of Well: (Describe each stratum or formation clearly, indicate if water bearing, and give thickness and depth as indicated.)

MATERIAL	Thickness (Feet)	Depth to Bottom (Feet)
<i>None</i>		

If log of well is not available, give name and address of driller. *Unknown*

**11. Infiltration Trench: Covered or open**

Dimensions: Length ..... ft. Minimum depth ..... ft. Maximum depth ..... ft.  
 Bottom width ..... ft. Discharge ..... g.p.m. Date of test .....

**12. Tunnel: Type of lining**

Dimensions: .....  
(Length, course, and cross sectional size)  
 Position of water bearing stratum with reference to portal of tunnel .....

Log of tunnel: (Preceding table for log of well may be used, if desired. Give footage from portal and character of materials, as pertinent.)

**13. Pumping Equipment:**


(a) Pump *Fairbanks Morse Cent 3"x2"* Capacity *350* g.p.m.  
(Make, type and size)  
 (b) Motor *10 HP Elec 3 phase*  
(Type and horsepower)

**14. Location of area irrigated or to be irrigated, or place of use if for purposes other than irrigation.**

Township North or South	Range E. or W. of Willamette Meridian	Section	Forty-acre Tract	Number Acres To Be Irrigated	Date of Reclamation
<i>16.5</i>	<i>14W</i>	<i>23</i>	<i>NW 1/4 NE 1/4</i>	<i>17.33</i>	<i>1949</i>
<i>16.5</i>	<i>"</i>	<i>23</i>	<i>SW 1/4 NE 1/4</i>	<i>15.0</i>	<i>"</i>
<i>"</i>	<i>"</i>	<i>"</i>	<i>SE 1/4 NW 1/4</i>	<i>15.0</i>	<i>"</i>
<i>"</i>	<i>"</i>	<i>"</i>	<i>NE 1/4 NW 1/4</i>	<i>20.13</i>	<i>"</i>
				<i>38.46</i>	<i>"</i>

15. If the ground water supply is supplemental to an existing water supply, identification of any application for a permit, permit, certificate or adjudicated right to appropriate water made or held by the registrant.

Township 16 S Range 4 W, W.M.  
North

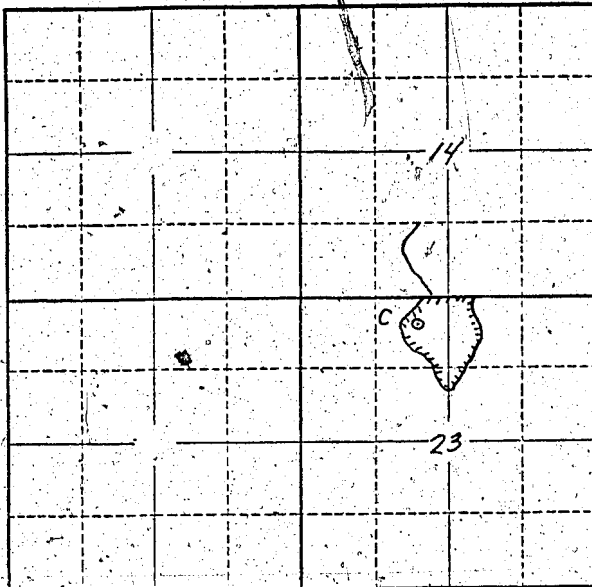

Locate well and acreage of irrigated land on plat.  
Scale: 2" = 1 Mile

STATE OF OREGON

County of Lane } ss.

I, Ronald J. Pitt, being first duly sworn, do hereby certify that I have read the foregoing Registration Statement and that all of the items therein contained are true to the best of my knowledge and belief.

Ronald J. Pitt  
(Signature of Registrant)

Subscribed and sworn to before me this 31 day of July, 1958

My commission expires 10-23-1958 W. W. Schmitt  
(Notary Public)

(SEAL)

**CERTIFICATE OF REGISTRATION**

STATE OF OREGON

County of Marion } ss.

This is to certify that the foregoing Registration Statement was received in the office of the State Engineer on the 1 day of August, 1958, at 5:00 o'clock A. M. and has been duly recorded in said office in Book No. 14 of Registration Statements on page OR 3360

Witness my hand this 20<sup>th</sup> day of August, 1959

W. A. Stanley  
(State Engineer)

By \_\_\_\_\_ (Deputy)

\$16.35