

Registration No. GR. 3666

Certificate No. GR. 3362

Registration Statement

OF CLAIMANT OF RIGHT TO APPROPRIATE GROUND WATER

TO THE STATE ENGINEER OF OREGON:

I, A. D. Anderson
of R.R.#3 (Mailing address) Junction City County of Lane
State of Oregon do hereby make application for a certificate of registration as evidence of a right to appropriate ground water.

1. Source from which water is withdrawn is Pump well #1
(Flowing well, pump well, infiltration trench, or tunnel)

2. Location is: 2 1/2 Miles N. Junction City
(Approximate distance and direction from nearest city or town)

and is more particularly described as follows:

(a) 3380' N. & 1420' E. of S.W. Cor. Sec. 18
(Give distance and bearing to corner of section or other legal subdivision)
being within _____ of Sec. 18, Twp. 15 S, Rge. 4 W
(Smallest legal subdivision) (N. or S.) (E. or W.)

or (b) within limits of recorded platted property, town or city:
in Lot _____, Block _____ of _____
(Name of plat or addition)

(If within city or town, give name) County of Lane

3. Construction Work was begun on 1953, was completed on 1953
(Date) (Date)

and the ground water claimed was first used for the purposes set out below on 1953,
since which time the water has been used Intermittently
(Continuously or Intermittently)
from 1953 to Present
(Date) (Date)

4. Quantity of water claimed and used is 250 gallons per minute; 85 acre feet per year.

5. Purpose or Purposes for which water is used Irrigation
(Domestic, irrigation, municipal, manufacturing, industrial, etc.)

6. Description of Well: Depth 21 feet. Type Drum
(Dug or drilled)
diameter 6 inches. Elevation of ground at well site 305 feet, mean sea level.
(As near as known)
Depth to water table 10 feet.

7. Capacity of Well: 400 g.p.m. with 2 feet drawdown.
_____ g.p.m. with _____ feet drawdown.

Date of test _____

If Flowing Well: Measured discharge _____ g.p.m. on _____ (Date)

Shut-in pressure at ground surface _____ lbs. per sq. in. on _____ (Date)

Water is controlled by _____ (Cap, valve, etc.)

8. Casing: (Give diameter, commercial specifications and depth below ground surface of each casing)

6 inch diameter from 0 to 21 feet
 inch diameter from to feet
 inch diameter from to feet
 inch diameter from to feet

Describe and show depth of shoe, plug, adapter, liner or other details:

9. Perforated Casings or Screens:

Standard p.c. perforations from 19 to 21
 (Number per foot and size of perforations, or describe screen)
 from to
 from to
 from to

10. Log of Well: (Describe each stratum or formation clearly, indicate if water bearing, and give thickness and depth as indicated.)

MATERIAL	Thickness (Feet)	Depth to Bottom (Feet)
Loam	4'	17'
Coarse Sand	4'	13'
Coarse gravel	13'	0'

If log of well is not available, give name and address of driller.

11. Infiltration Trench: Covered or open _____
 Dimensions: Length _____ ft. Minimum depth _____ ft. Maximum depth _____ ft.
 Bottom width _____ ft. Discharge _____ g.p.m. Date of test _____

12. Tunnel: Type of lining _____
 Dimensions: _____
(Length, course, and cross sectional size)
 Position of water bearing stratum with reference to portal of tunnel _____

Log of tunnel: (Preceding table for log of well may be used, if desired. Give footage from portal and character of materials, as pertinent.)


13. Pumping Equipment:
 (a) Pump Cornell - Centrif - 2 1/2" Capacity 250 g.p.m.
(Make, type and size)
 (b) Motor Elec 3-ph - 15 H.P.
(Type and horsepower)

14. Location of area irrigated or to be irrigated, or place of use if for purposes other than irrigation.

Township North or South	Range E. or W. of Willamette Meridian	Section	Forty-acre Tract	Number Acres To Be Irrigated	Date of Reclamation
15-S	4-W	18	S.W. 1/4 of N.W. 1/4	4	1953
"	"	"	S.E. 1/4 of N.W. 1/4	23	"
"	"	"	S.W. 1/4 of N.E. 1/4	4	"
"	"	"	N.W. 1/4 of S.W. 1/4	2	"
"	"	"	N.E. 1/4 of S.W. 1/4	7.6	"
"	"	"	N.W. 1/4 of S.E. 1/4	0.4	"
				<u>41.0</u>	

15. If the ground water supply is supplemental to an existing water supply, identification of any application for a permit, permit, certificate or adjudicated right to appropriate water made or held by the registrant.

Township 15.S Range 4W W.M.
North

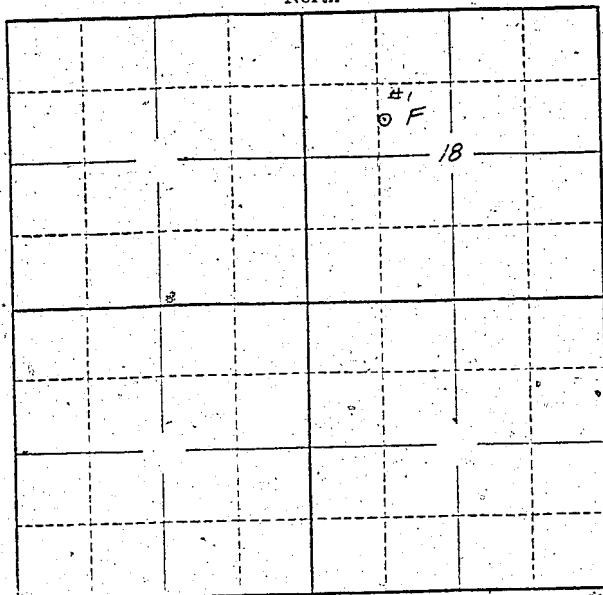

Locate well and acreage of irrigated land on plat.
Scale: 2" = 1 Mile

STATE OF OREGON }
County of Lane } ss.

I, S. D. Anderson, being first duly sworn, do hereby certify that I have read the foregoing Registration Statement and that all of the items therein contained are true to the best of my knowledge and belief.

S. D. Anderson
(Signature of Registrant)

Subscribed and sworn to before me this 21 day of July, 1955

My commission expires Apr 20 1960 W. M. Peterson
(Notary Public)

(SEAL)

CERTIFICATE OF REGISTRATION

STATE OF OREGON }
County of Marion } ss.

This is to certify that the foregoing Registration Statement was received in the office of the State Engineer on the _____ day of _____, 19____, at _____ o'clock _____ M. and has been duly recorded in said office in Book No. 14 of Registration Statements on page 3362

Witness my hand this 20th day of August, 1959

[Signature]
(State Engineer)

By _____ (Deputy)

GR 3362



\$16.65