

# Registration Statement

## OF CLAIMANT OF RIGHT TO APPROPRIATE GROUND WATER

TO THE STATE ENGINEER OF OREGON:

I, Albert Loran  
of State Route, Box 47, Newberg County of Marian  
(Mailing address)

State of Ore, do hereby make application for a certificate of registration as evidence of a right to appropriate ground water.

1. Source from which water is withdrawn is well  
(Flowing well, pump well, infiltration trench, or tunnel)

2. Location is: on Highway between St Paul & Newberg  
(Approximate distance and direction from nearest city or town)

and is more particularly described as follows:

(a) 2600' N 4.2150' E from SW Corner Section 4  
(Give distance and bearing to corner of section or other legal subdivision)

being within NE 1/4 SW 1/4 of Sec. 4, Twp. 45, Rge. 2W  
(Smallest legal subdivision) (N. or S.) (E. or W.)

or (b) within limits of recorded platted property, town or city:

in Lot \_\_\_\_\_, Block \_\_\_\_\_ of \_\_\_\_\_  
(Name of plat or addition)

County of \_\_\_\_\_  
(If within city or town, give name)

3. Construction Work was begun on May 1952; was completed on May 1952  
(Date) (Date)

and the ground water claimed was first used for the purposes set out below on May 1952  
(Date)

since which time the water has been used Continuously during season  
(Continuously or intermittently)

from May to Oct  
(Date) (Date)

4. Quantity of water claimed and used is 112 gallons per minute; 112 3/4 acre feet per year.

5. Purpose or Purposes for which water is used Partly Pasture  
(Domestic, irrigation, municipal, manufacturing, industrial, etc.)

6. Description of Well: Depth 130 feet. Type Drilled  
(Dug or drilled)

diameter 8 inches. Elevation of ground at well site \_\_\_\_\_ feet, mean sea level.  
(As near as known)

Depth to water table \_\_\_\_\_ feet.

7. Capacity of Well: 225 g.p.m. with \_\_\_\_\_ feet drawdown.

\_\_\_\_\_ g.p.m. with \_\_\_\_\_ feet drawdown.

Date of test May 1952

If Flowing Well: Measured discharge \_\_\_\_\_ g.p.m. on \_\_\_\_\_  
(Date)


Shut-in pressure at ground surface \_\_\_\_\_ lbs. per sq. in. on \_\_\_\_\_  
(Date)

Water is controlled by \_\_\_\_\_  
(Cap, valve, etc.)





Township 45 Range 2W, W.M.  
North

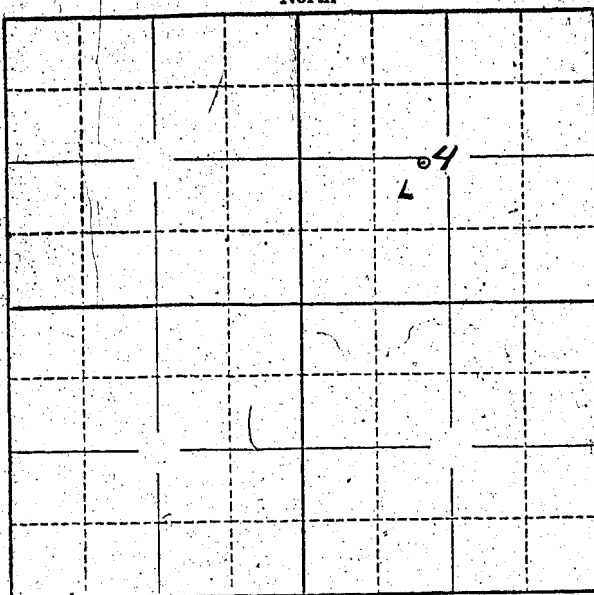

Locate well and acreage of irrigated land on plat.  
Scale: 2" = 1 Mile

STATE OF OREGON

County of Marion

} ss.

I, Albert Swan, being first duly sworn, do hereby certify that I have read the foregoing Registration Statement and that all of the items therein contained are true to the best of my knowledge and belief.

Albert Swan  
(Signature of Registrant)

Subscribed and sworn to before me this 1st day of August, 1958

My commission expires 12th June 1961

Wm. S. Bartholomew  
(Notary Public)

(SEAL)

### CERTIFICATE OF REGISTRATION

STATE OF OREGON

County of Marion

} ss.

This is to certify that the foregoing Registration Statement was received in the office of the State Engineer on the 1st day of August, 1958, at 12:45 o'clock A. M. and has been duly recorded in said office in Book No. 14 of Registration Statements on page GR-3365

Witness my hand this 20th day of August, 1959

Lewis A. Stanley  
(State Engineer)

By

(Deputy)

GR - 3365

\$15.60