

Registration Statement

OF CLAIMANT OF RIGHT TO APPROPRIATE GROUND WATER

TO THE STATE ENGINEER OF OREGON:

I, Elsie P. Strome

of 1425 Highway 99E, Junction City County of Lane

State of Oregon, do hereby make application for a certificate of registration as evidence of a right to appropriate ground water.

1. Source from which water is withdrawn is Pump well
(Flowing well, pump well, infiltration trench, or tunnel)

2. Location is: 2 miles North Junction City
(Approximate distance and direction from nearest city or town)

and is more particularly described as follows:

(a) 670.0 ft S 45° 30' W from NE corner of Sec. 20
(Give distance and bearing to corner of section or other legal subdivision)

being within S.W. 1/4 of S.W. 1/4 of Sec. 20, Twp. 15S, Rge. R4W
(Smallest legal subdivision) (N. or S.) (E. or W.)

or (b) within limits of recorded platted property, town or city:

in Lot _____, Block _____ of _____
(Name of plat or addition)

County of _____
(If within city or town, give name)

3. Construction Work was begun on 1938; was completed on 1938
(Date) (Date)

and the ground water claimed was first used for the purposes set out below on 1938
(Date)

since which time the water has been used intermittently
(Continuously or intermittently)

from 1937 to July 1958
(Date) (Date)

4. Quantity of water claimed and used is 650 gallons per minute; 1.66 acre feet per year.

5. Purpose or Purposes for which water is used irrigation
(Domestic, irrigation, municipal, manufacturing, industrial, etc.)

6. Description of Well: Depth 21 feet, Type Drivern
(Dug or drilled)

diameter 4 inches. Elevation of ground at well site 500 feet, mean sea level.
(As near as known)

Depth to water table 10 feet.

7. Capacity of Well: 650 g.p.m. with 4 feet drawdown.

_____ g.p.m. with _____ feet drawdown.

Date of test _____


If Flowing Well: Measured discharge _____ g.p.m. on _____
(Date)

Shut-in pressure at ground surface _____ lbs. per sq. in. on _____
(Date)

Water is controlled by _____
(Cap, valve, etc.)

Township 15S Range 4W, W.M.

North

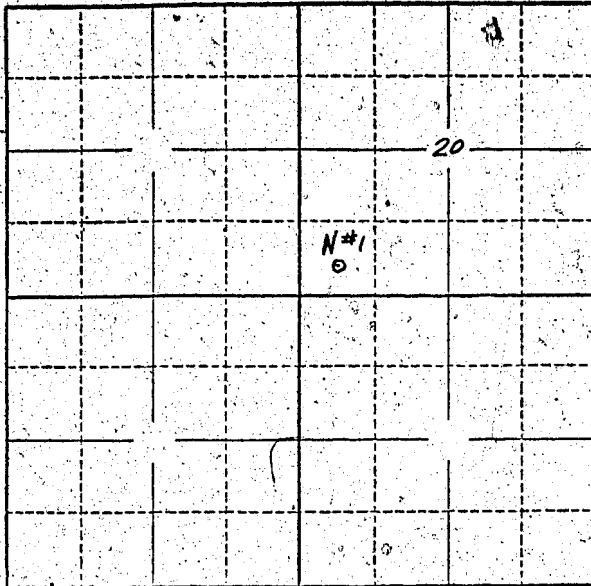

Locate well and acreage of irrigated land on plat.

Scale: 2" = 1 Mile

STATE OF OREGON

County of Linn } ss.

I, Elaine P. Strone, being first duly sworn, do hereby certify that I have read the foregoing Registration Statement and that all of the items therein contained are true to the best of my knowledge and belief.

Elaine P. Strone
(Signature of Registrant)

Subscribed and sworn to before me this 28th day of July, 1958

My commission expires April 11, 1960 Edna Strubath
(Notary Public)

(SEAL)

CERTIFICATE OF REGISTRATION

STATE OF OREGON

County of Marion } ss.

This is to certify that the foregoing Registration Statement was received in the office of the State Engineer on the 4th day of August, 1958 at 8:00 o'clock A. M. and has been duly recorded in said office in Book No. 14 of Registration Statements on page GR-3366

Witness my hand this 20th day of August, 1959

Lewis A. Stanley
(State Engineer)

By _____
(Deputy)

24.45

GR-3366